


T.8S.,R.2W.,W.M.

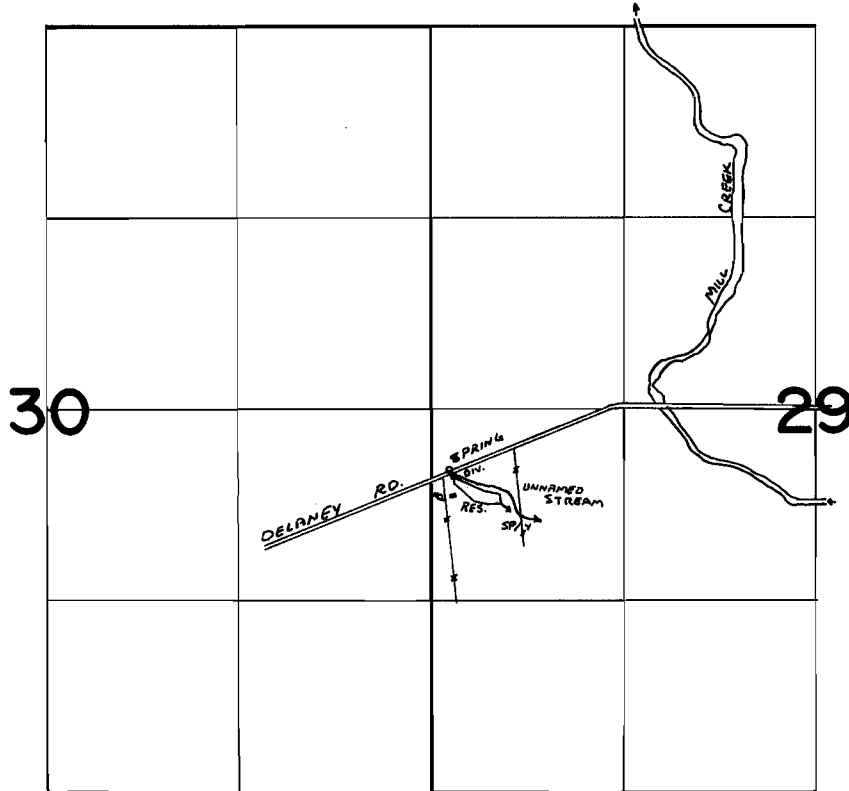

STR. DIV: 350' S AND 150' E }
DAM LOC: 600' S AND 480' E } FROM W 1/4 COR. SEC. 29

FINAL PROOF SURVEY
UNDER

Application No. R-49584 Permit No. R-5846
49585 36099
IN NAME OF

William J. & Ocie F. Phillips

Surveyed SEPT. 30 1975, by L. Toll