


T.8S.,R.2W.,W.M.

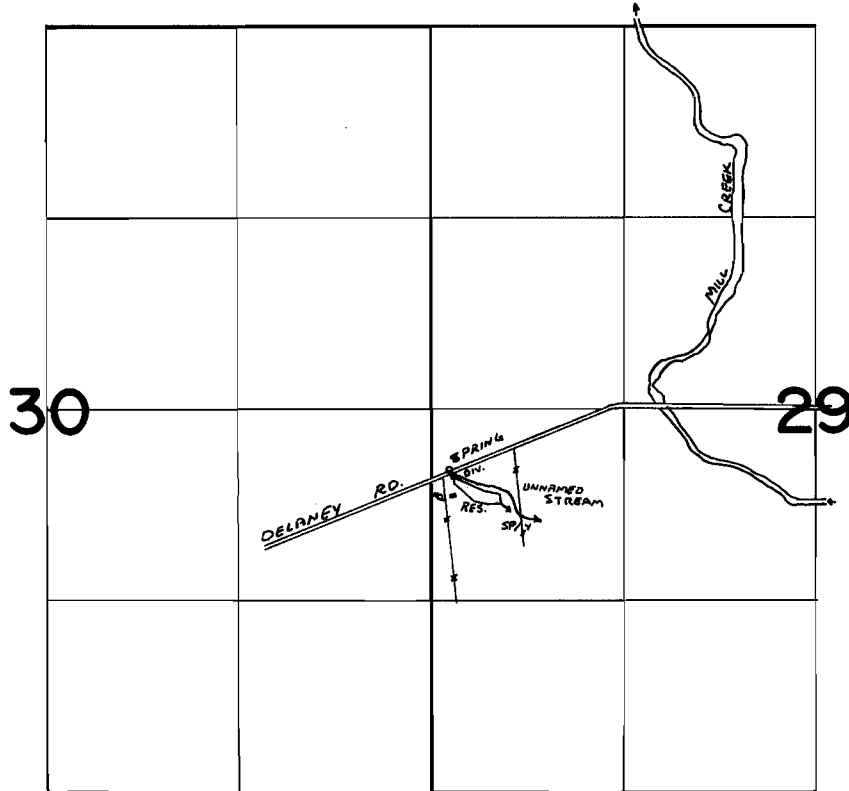

STR. DIV: 350' S AND 150' E }  
DAM LOC: 600' S AND 480' E } FROM W 1/4 COR. SEC. 29

**FINAL PROOF SURVEY**  
UNDER

Application No. R-49584 49585 Permit No. R-5846 36099  
IN NAME OF

William J. & Ocie F. Phillips

Surveyed SEPT. 30 1975, by L. Toll