


T.1S. R.3E. W.M.

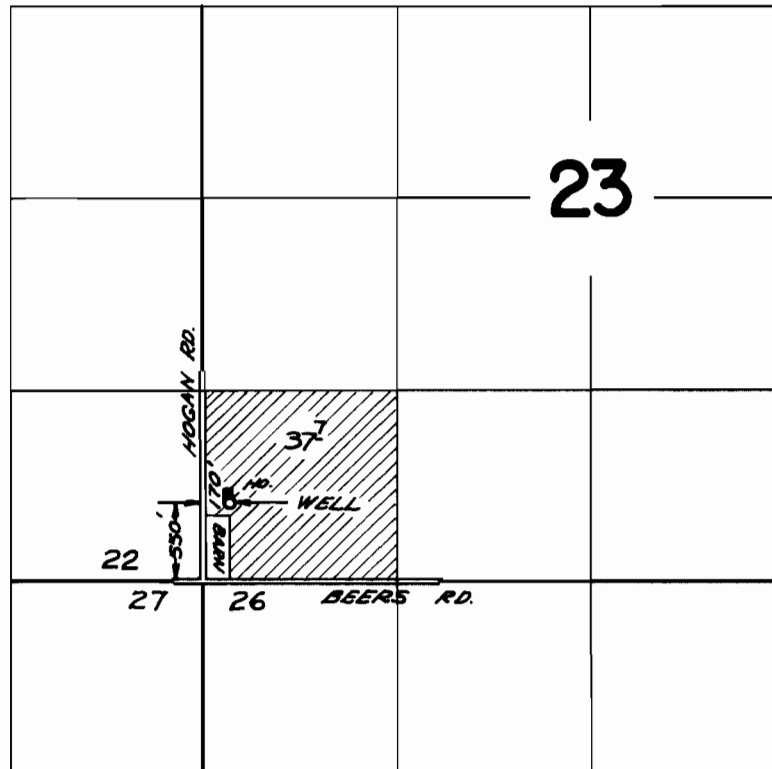

FINAL PROOF SURVEY
UNDER

Application No. G-2529 Permit No. G-2344
IN NAME OF

CLETUS J. RUPP

Surveyed Sept. 2 1966, by V. GARNER