
T.16S.,R.5E.,W.M.

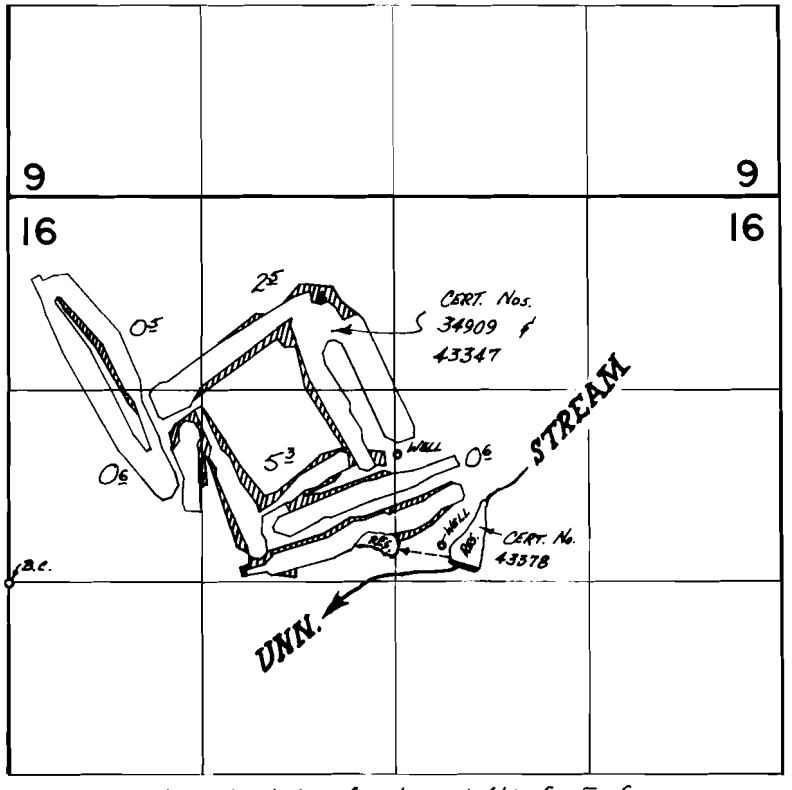

Div. pt. located 100 ft. N. and 440 ft. E. from the center of Section 16.

FINAL PROOF SURVEY
UNDER

Application No. 54390 Permit No. 40759
IN NAME OF

N. B. GIUSTINA

Surveyed Aug. 17 1977, by L.M. Tolle

1967-C, & 1977-U