


T.5 S. R.1 E. W.M.

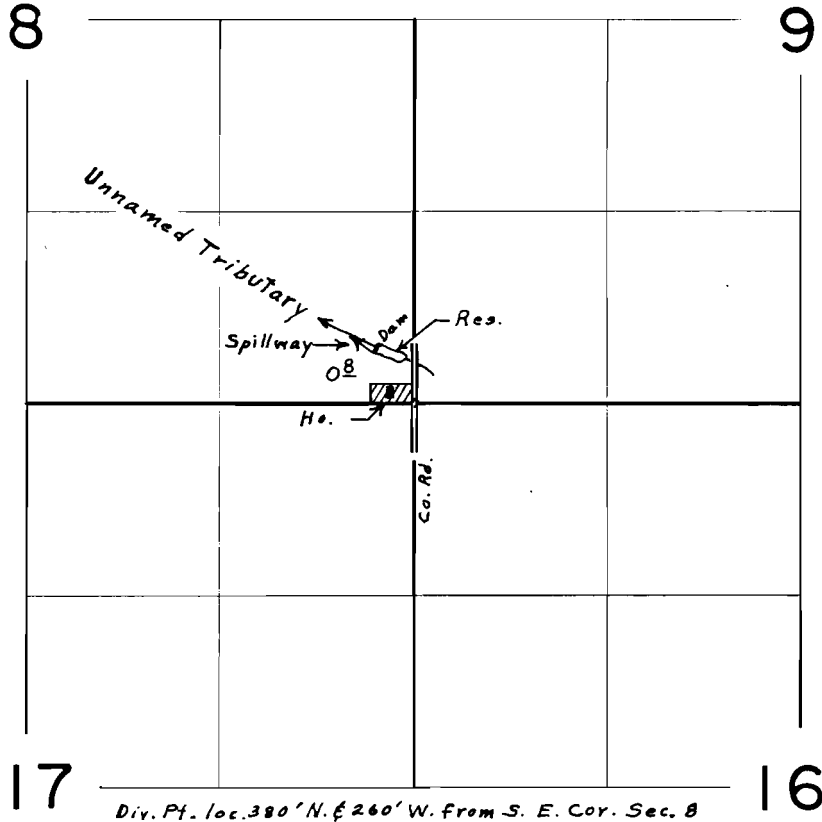

FINAL PROOF SURVEY
UNDER

R-50068
Application No. 50069 Permit No. 37844
IN NAME OF

Fred Cutler

Surveyed Mar. 22, 1976, by L. E. Gruid