


T.5 S. R.1 E. W.M.

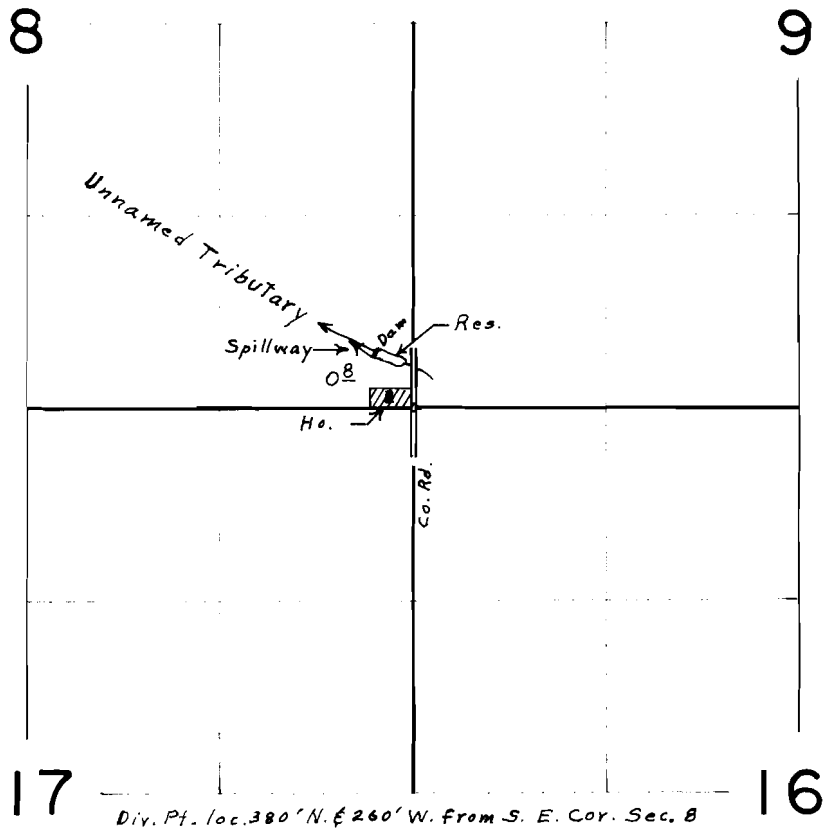

**FINAL PROOF SURVEY**  
UNDER

R-50068 R-6126  
Application No. 50069 Permit No. 37844  
IN NAME OF

Fred Cutler

Surveyed Mar. 29, 1976, by L. E. Gould