



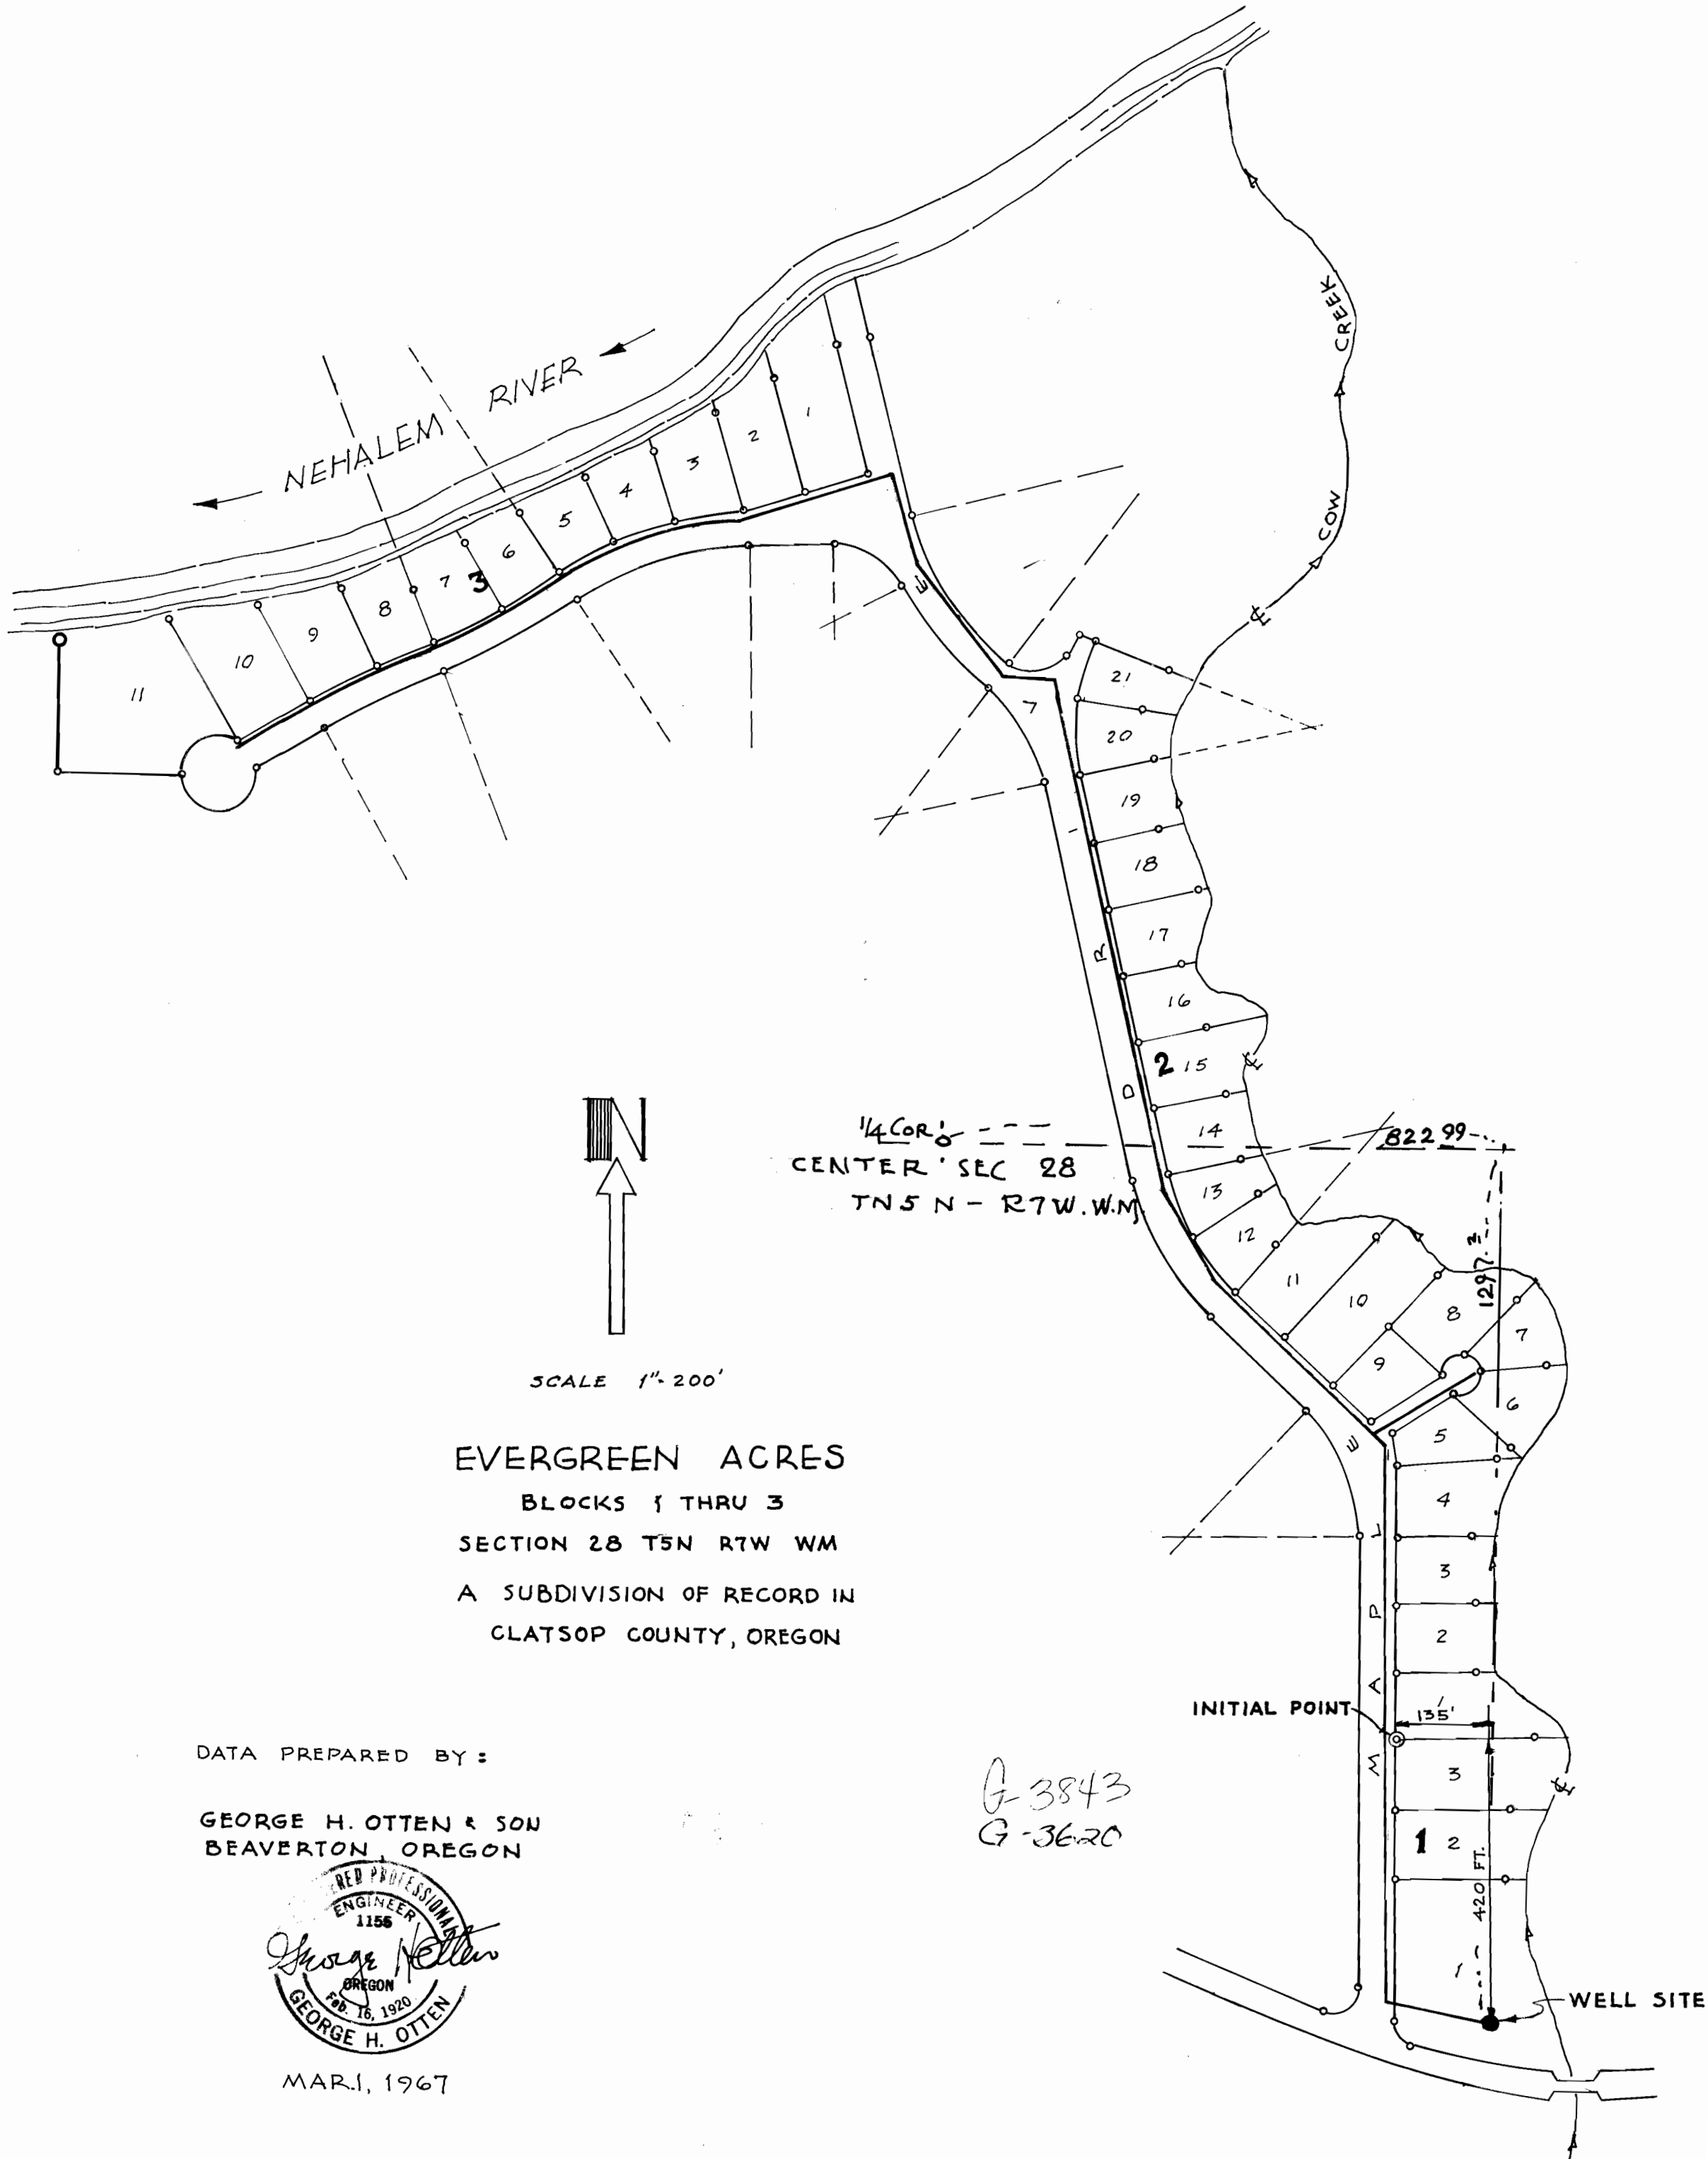

NEHALEM RIVER

COW CREEK

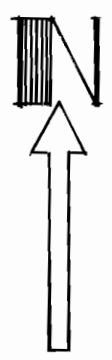


SCALE 1"=200'

EVERGREEN ACRES  
BLOCKS 1 THRU 3  
SECTION 28 T5N R7W WM  
A SUBDIVISION OF RECORD IN  
CLATSOP COUNTY, OREGON

DATA PREPARED BY:

GEORGE H. OTTEN & SON  
BEAVERTON, OREGON

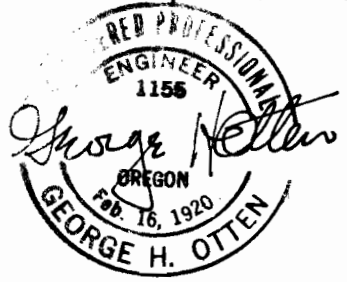

MAR. 1, 1967

1/4 COR. 6 ---  
CENTER SEC 28  
T5N R7W WM

822.99

1297.3

INITIAL POINT

135'

420 FT.

WELL SITE

G-3843  
G-3620