


T.8N.,R.7W.,W.M.

SW ¼ NE ¼ SEC. 15

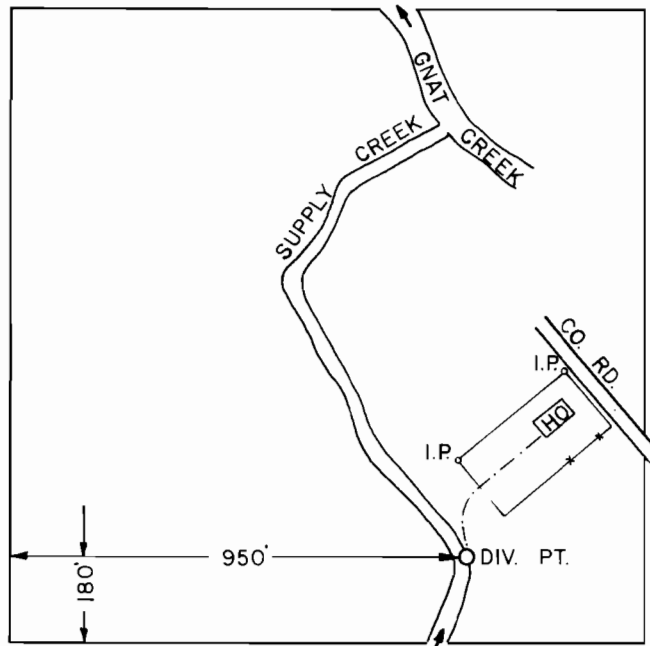

SCALE: 1" = 400'

FINAL PROOF SURVEY
UNDER

Application No. 51974 Permit No. 37869
IN NAME OF

ERIC D. & MARGARET L. GREGORY

Surveyed JUNE 22 1976, by L. TOLL