


T.27S., R.11W., W.M.

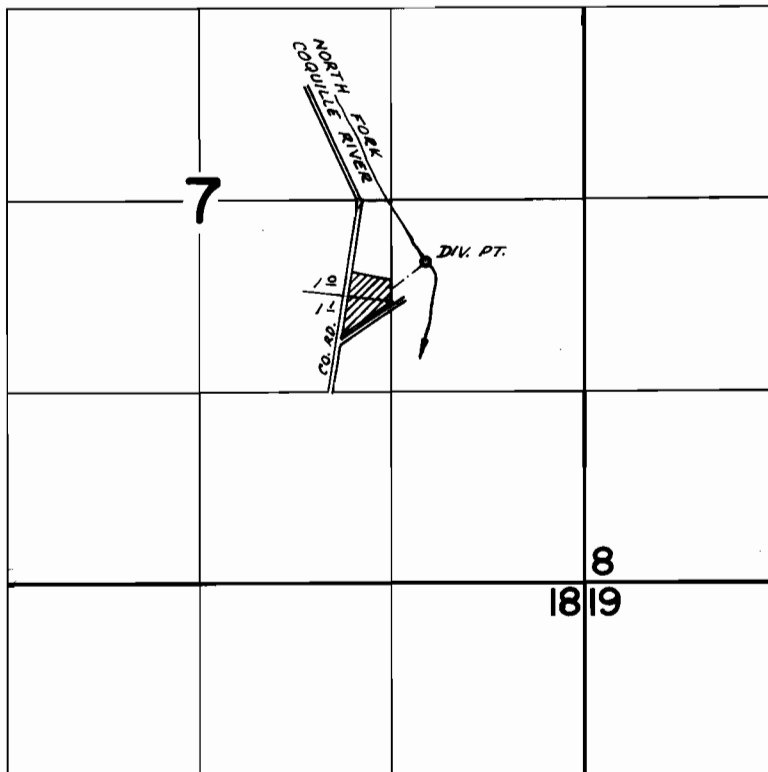

DIV. PT. LOC: 420' S & 230' E FROM NW COR. NE 1/4 SE 1/4 SEC. 7

**FINAL PROOF SURVEY**  
UNDER

Application No. 48095 Permit No. 36118  
IN NAME OF

KATHLEEN & WILLIAM GARR

Surveyed July 17 1976, by D. Norby