


T.27S., R.12W., W.M.

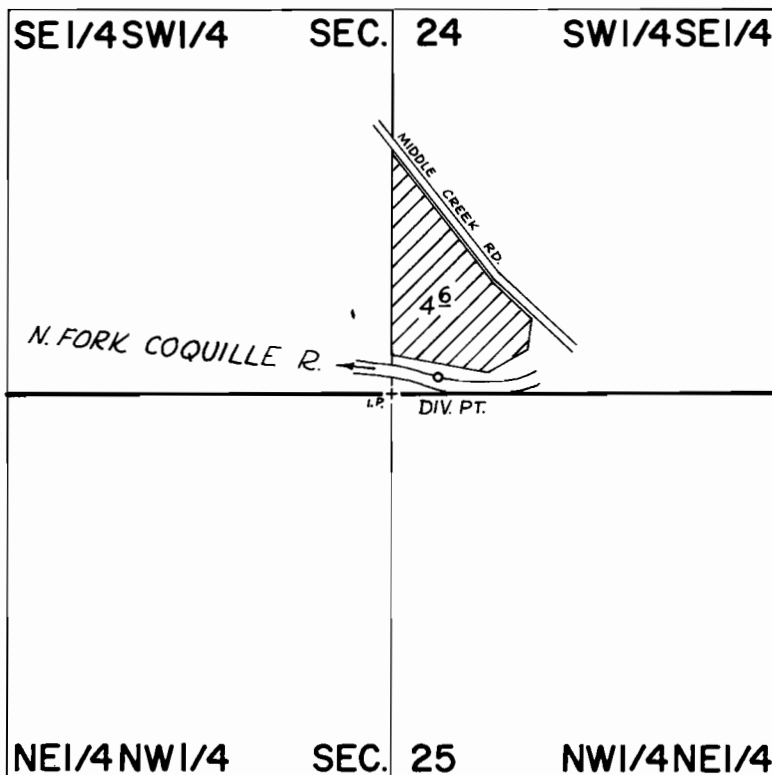

DIV. PT. LOC: 60' N & 160' E FROM S 1/4 COR. SEC. 24

Scale: 1" = 660'

FINAL PROOF SURVEY
UNDER

Application No. 51727 Permit No. 38995
IN NAME OF

CHARLES WAYNE ABBEY

Surveyed July 17 1976, by D. Norby