


T.28S. R.6W. W.M.

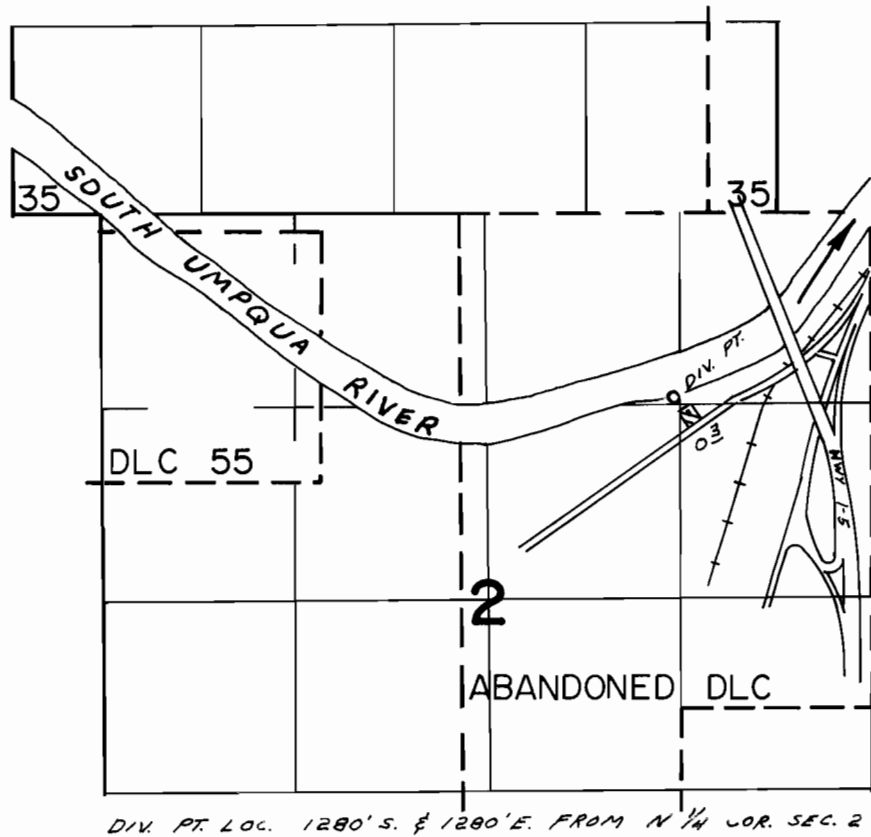

FINAL PROOF SURVEY
UNDER

Application No. 51033 Permit No. 38515
IN NAME OF

.....
QUENTIN A. BROWN
.....

Surveyed APR. 7, 1976, by L.H. NUNN