


T. 20 S., R. 6 W., W.M.

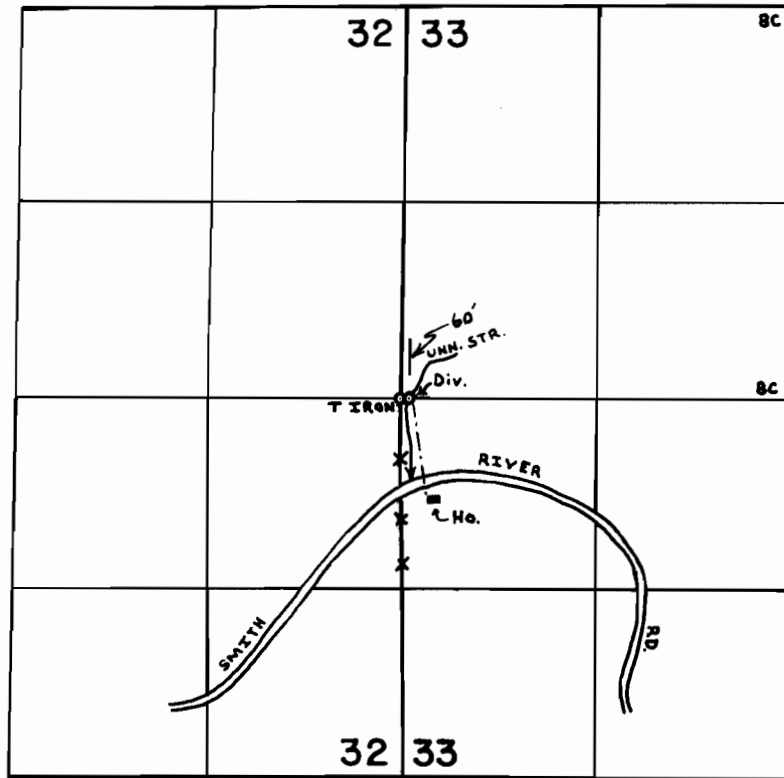

FINAL PROOF SURVEY
UNDER

Application No. 53201 Permit No. 38222
IN NAME OF

ROLAND R. HANSELMANN

Surveyed FEB. 24. 1978. by D.W. SPARKS