


T. 27S., R. 3 W., W.M.

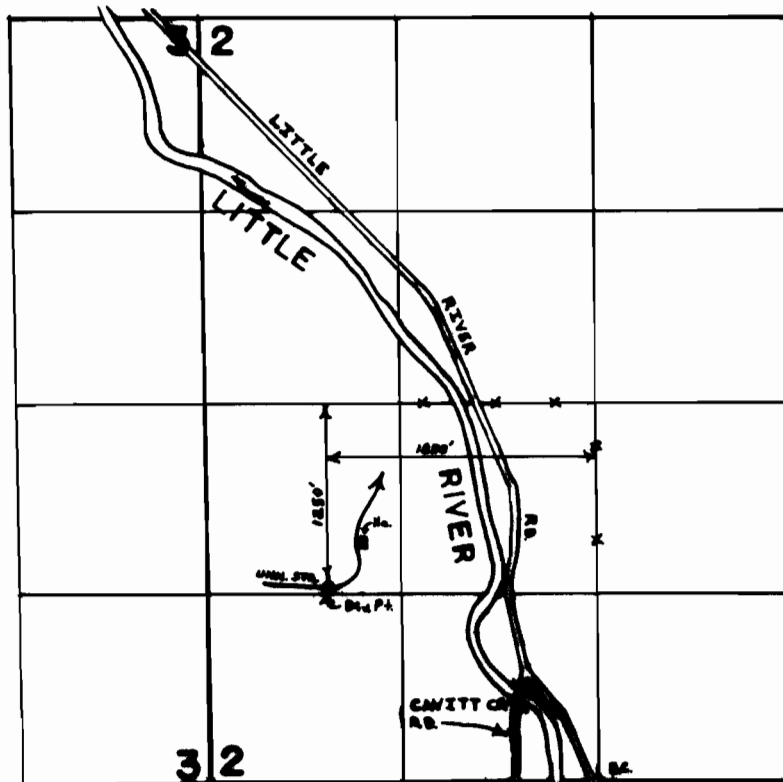

FINAL PROOF SURVEY
UNDER

Application No. 48661... Permit No. 36495...
IN NAME OF

A. MORNARICH

MAY 5 1978 D. W. SPARKS
Surveyed APRIL 8 1976, by D. NORBY