


TOWNSHIP 1 N., RANGE 20 E

4

3

9

10

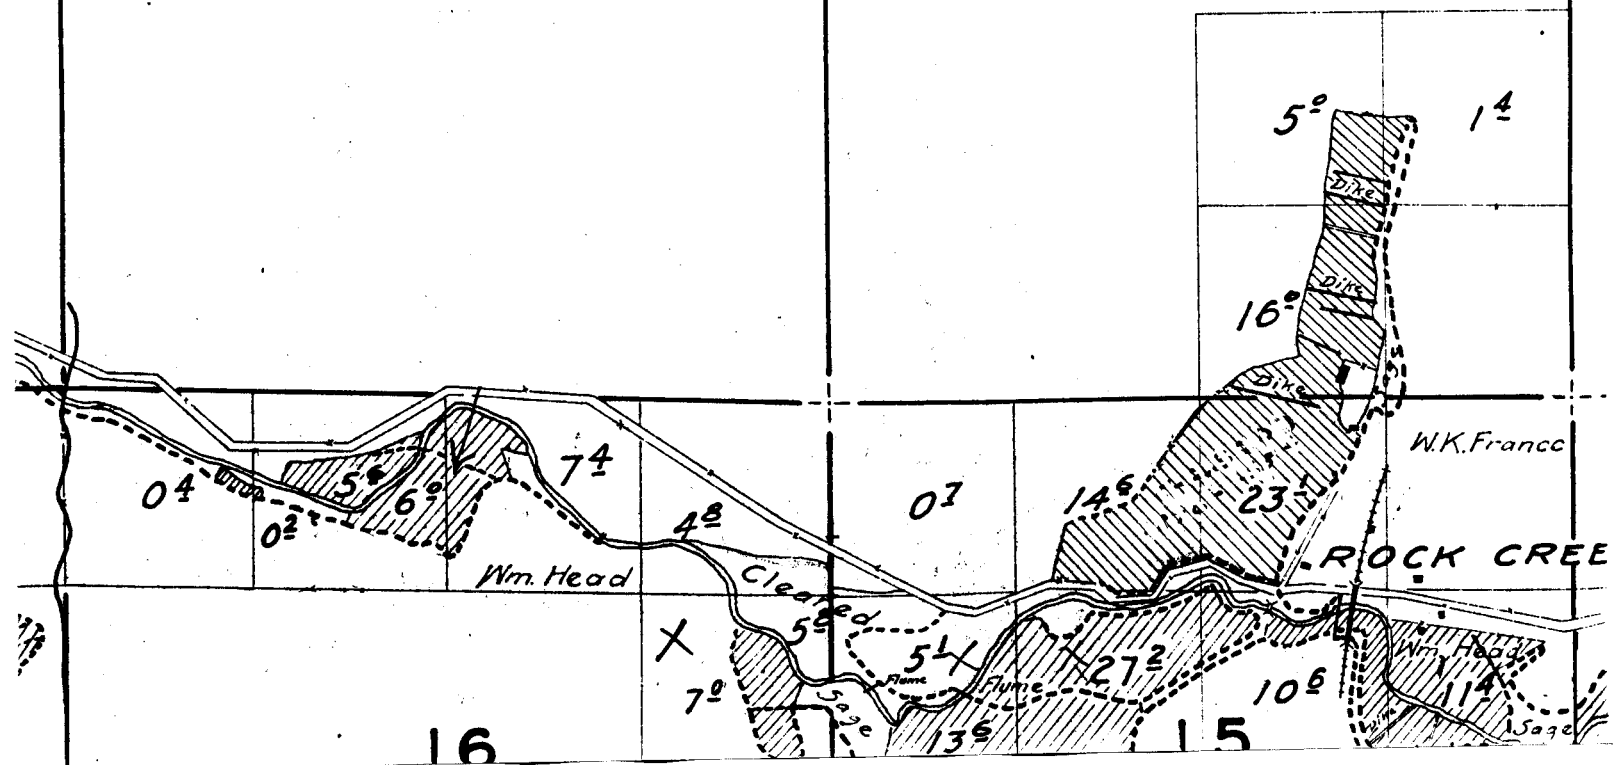

W.K. Franco

ROCK CREE

Wm. Head

Cleared

Dike

14

5⁰

16⁰

04

02

05

06

74

48

07

146

23

70

54

272

105

114

1590

16

15


135


ANGE 20 E.

4-2-1

3	2	1
---	---	---

10	11	12
----	----	----

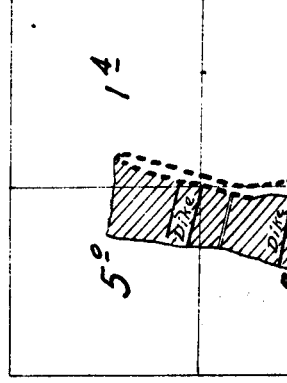

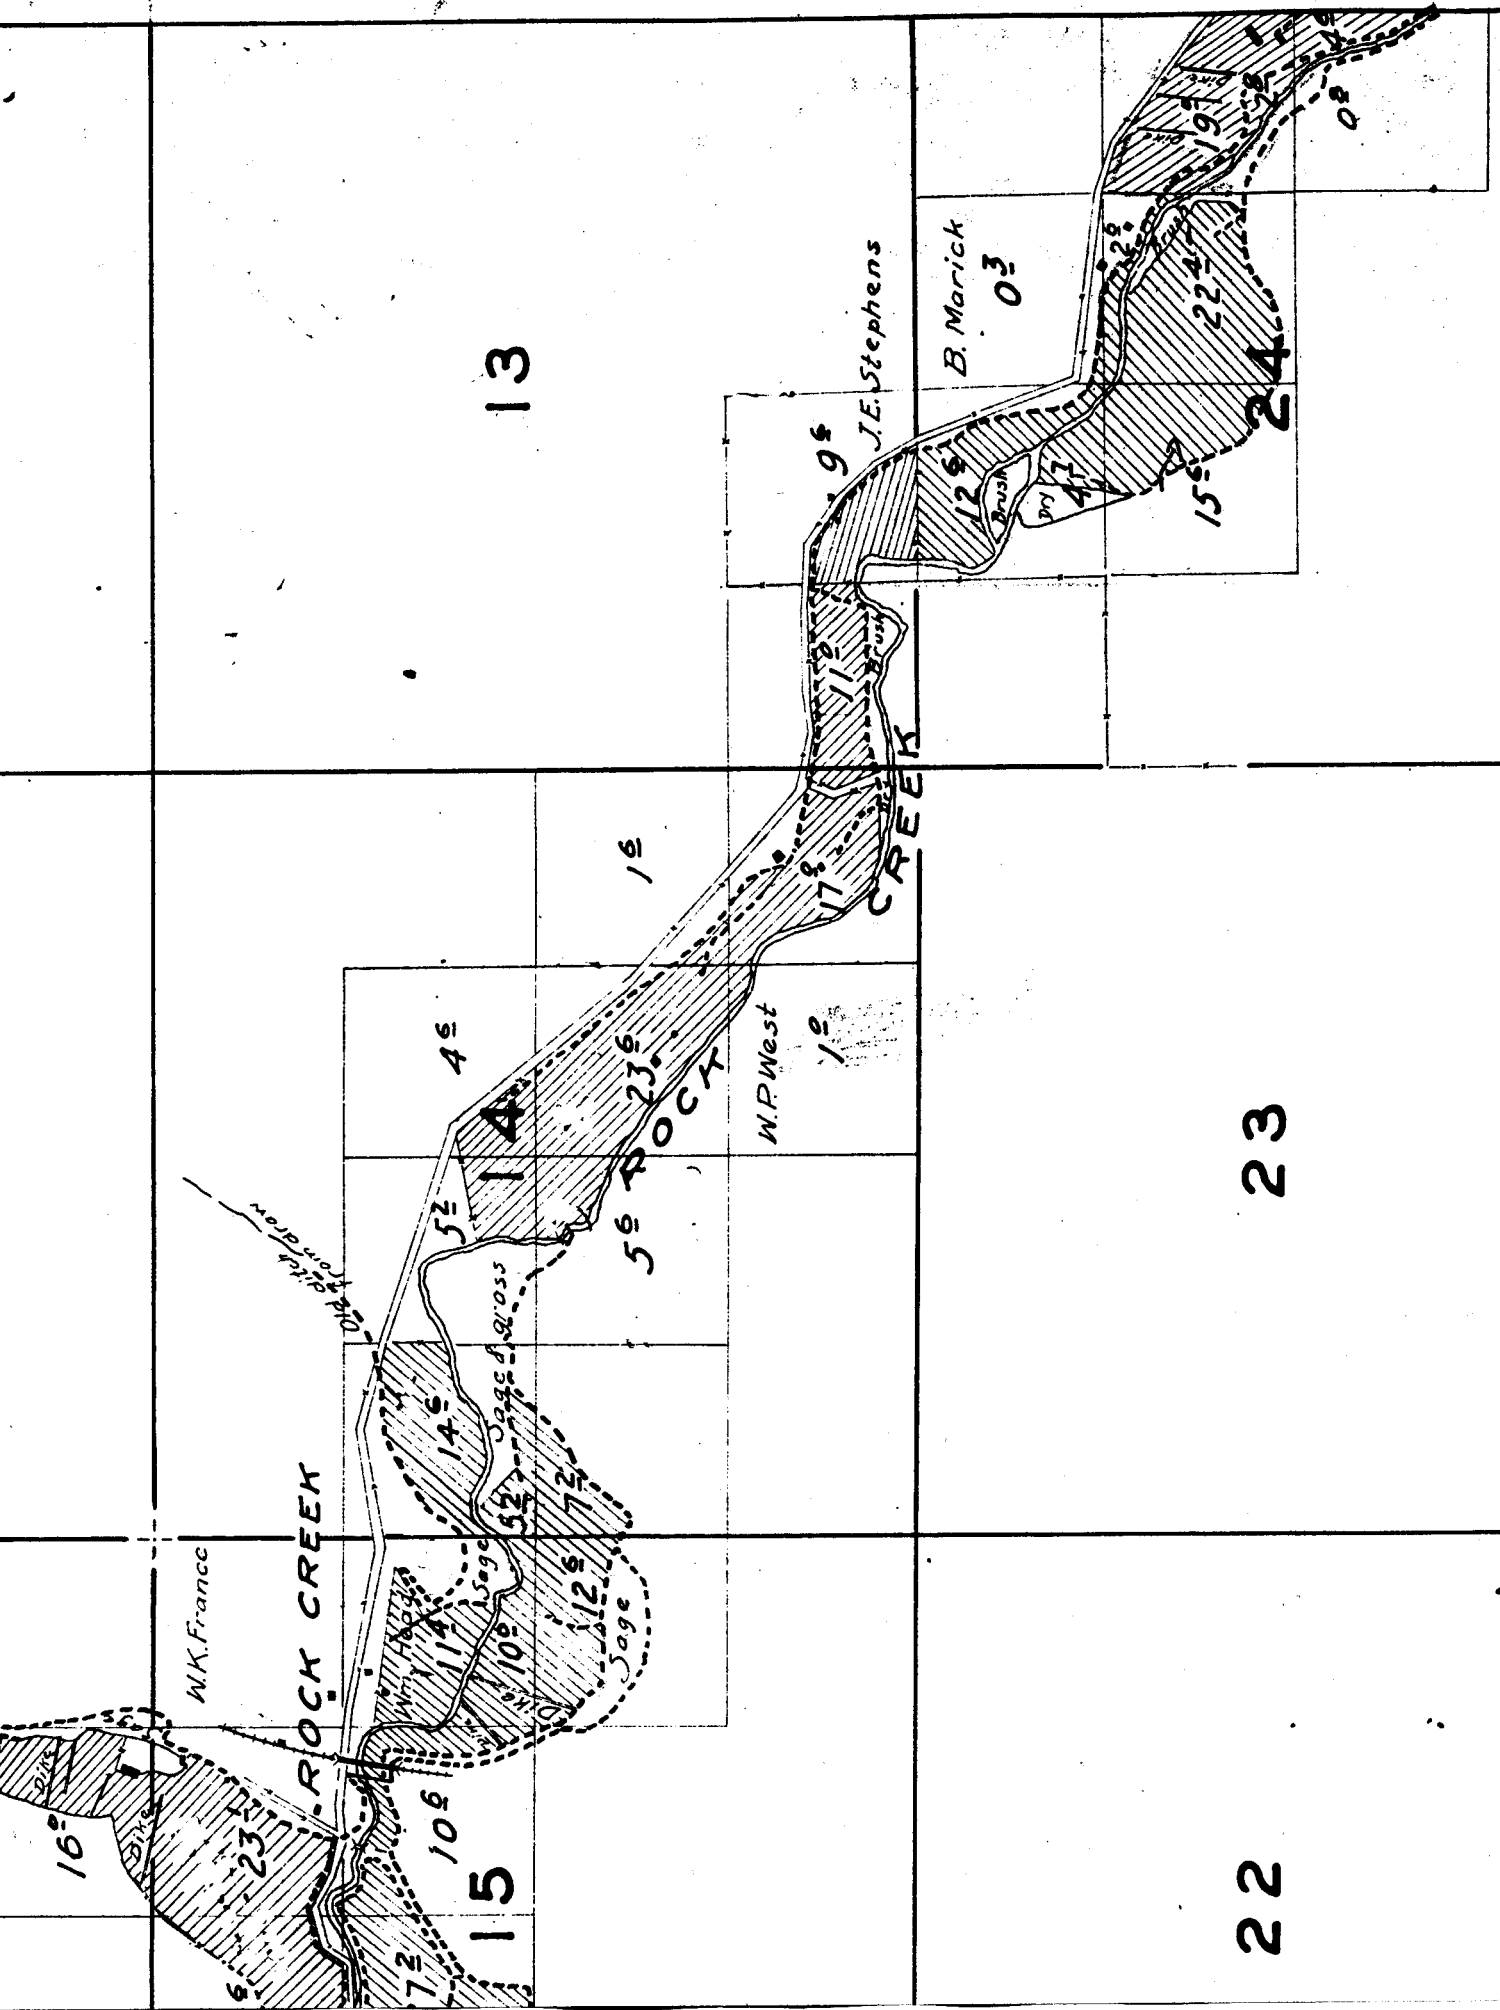

22

23


35

36

26

25

23

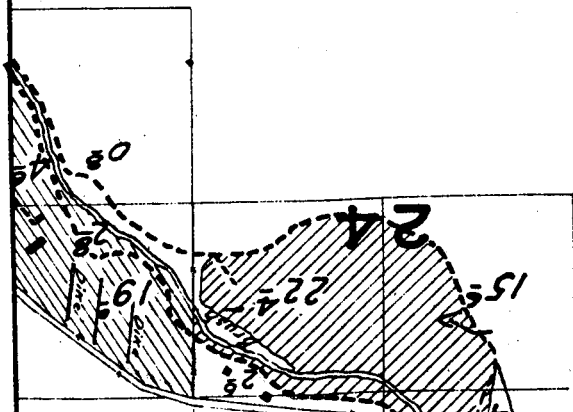

32


31


29

30

20

19

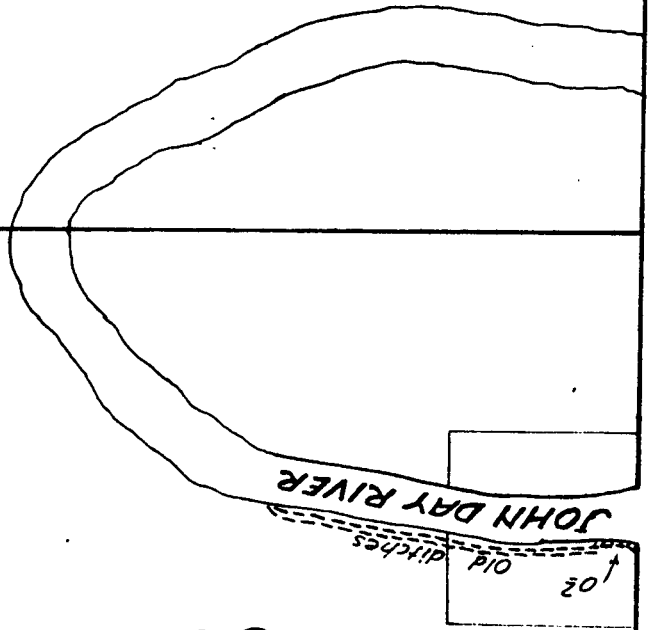

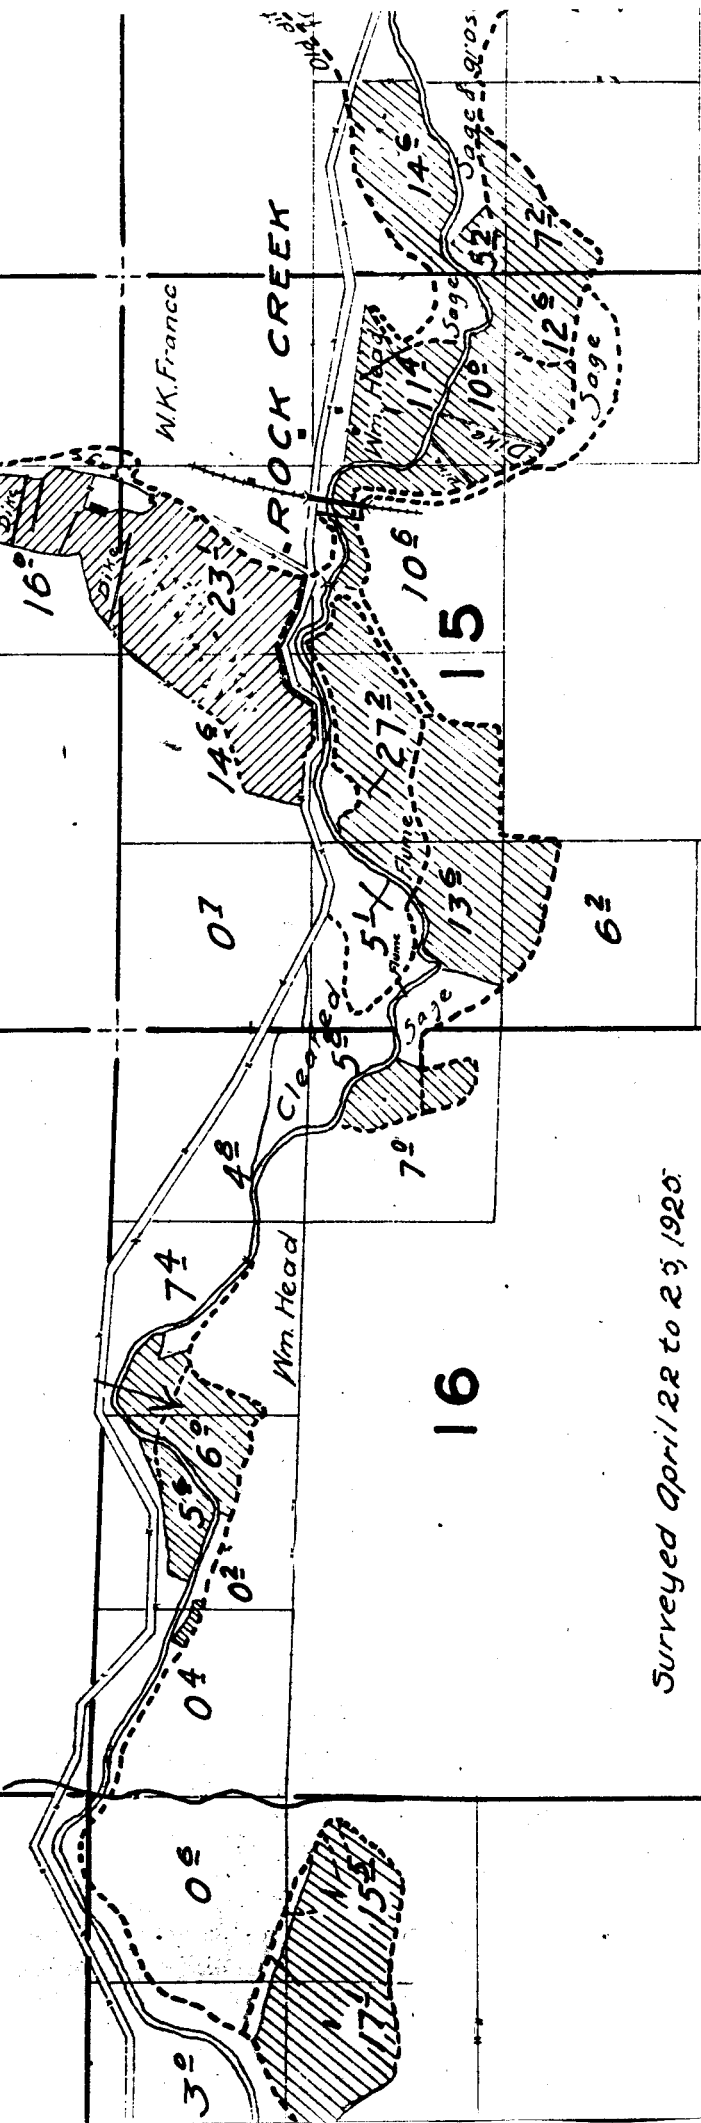

Surveyed April 22 to 23, 1920.

21

Note:
Streams and roads, except in
the vicinity of irrigated land,
are sketched in approximate
location.


22

27

34

28

33

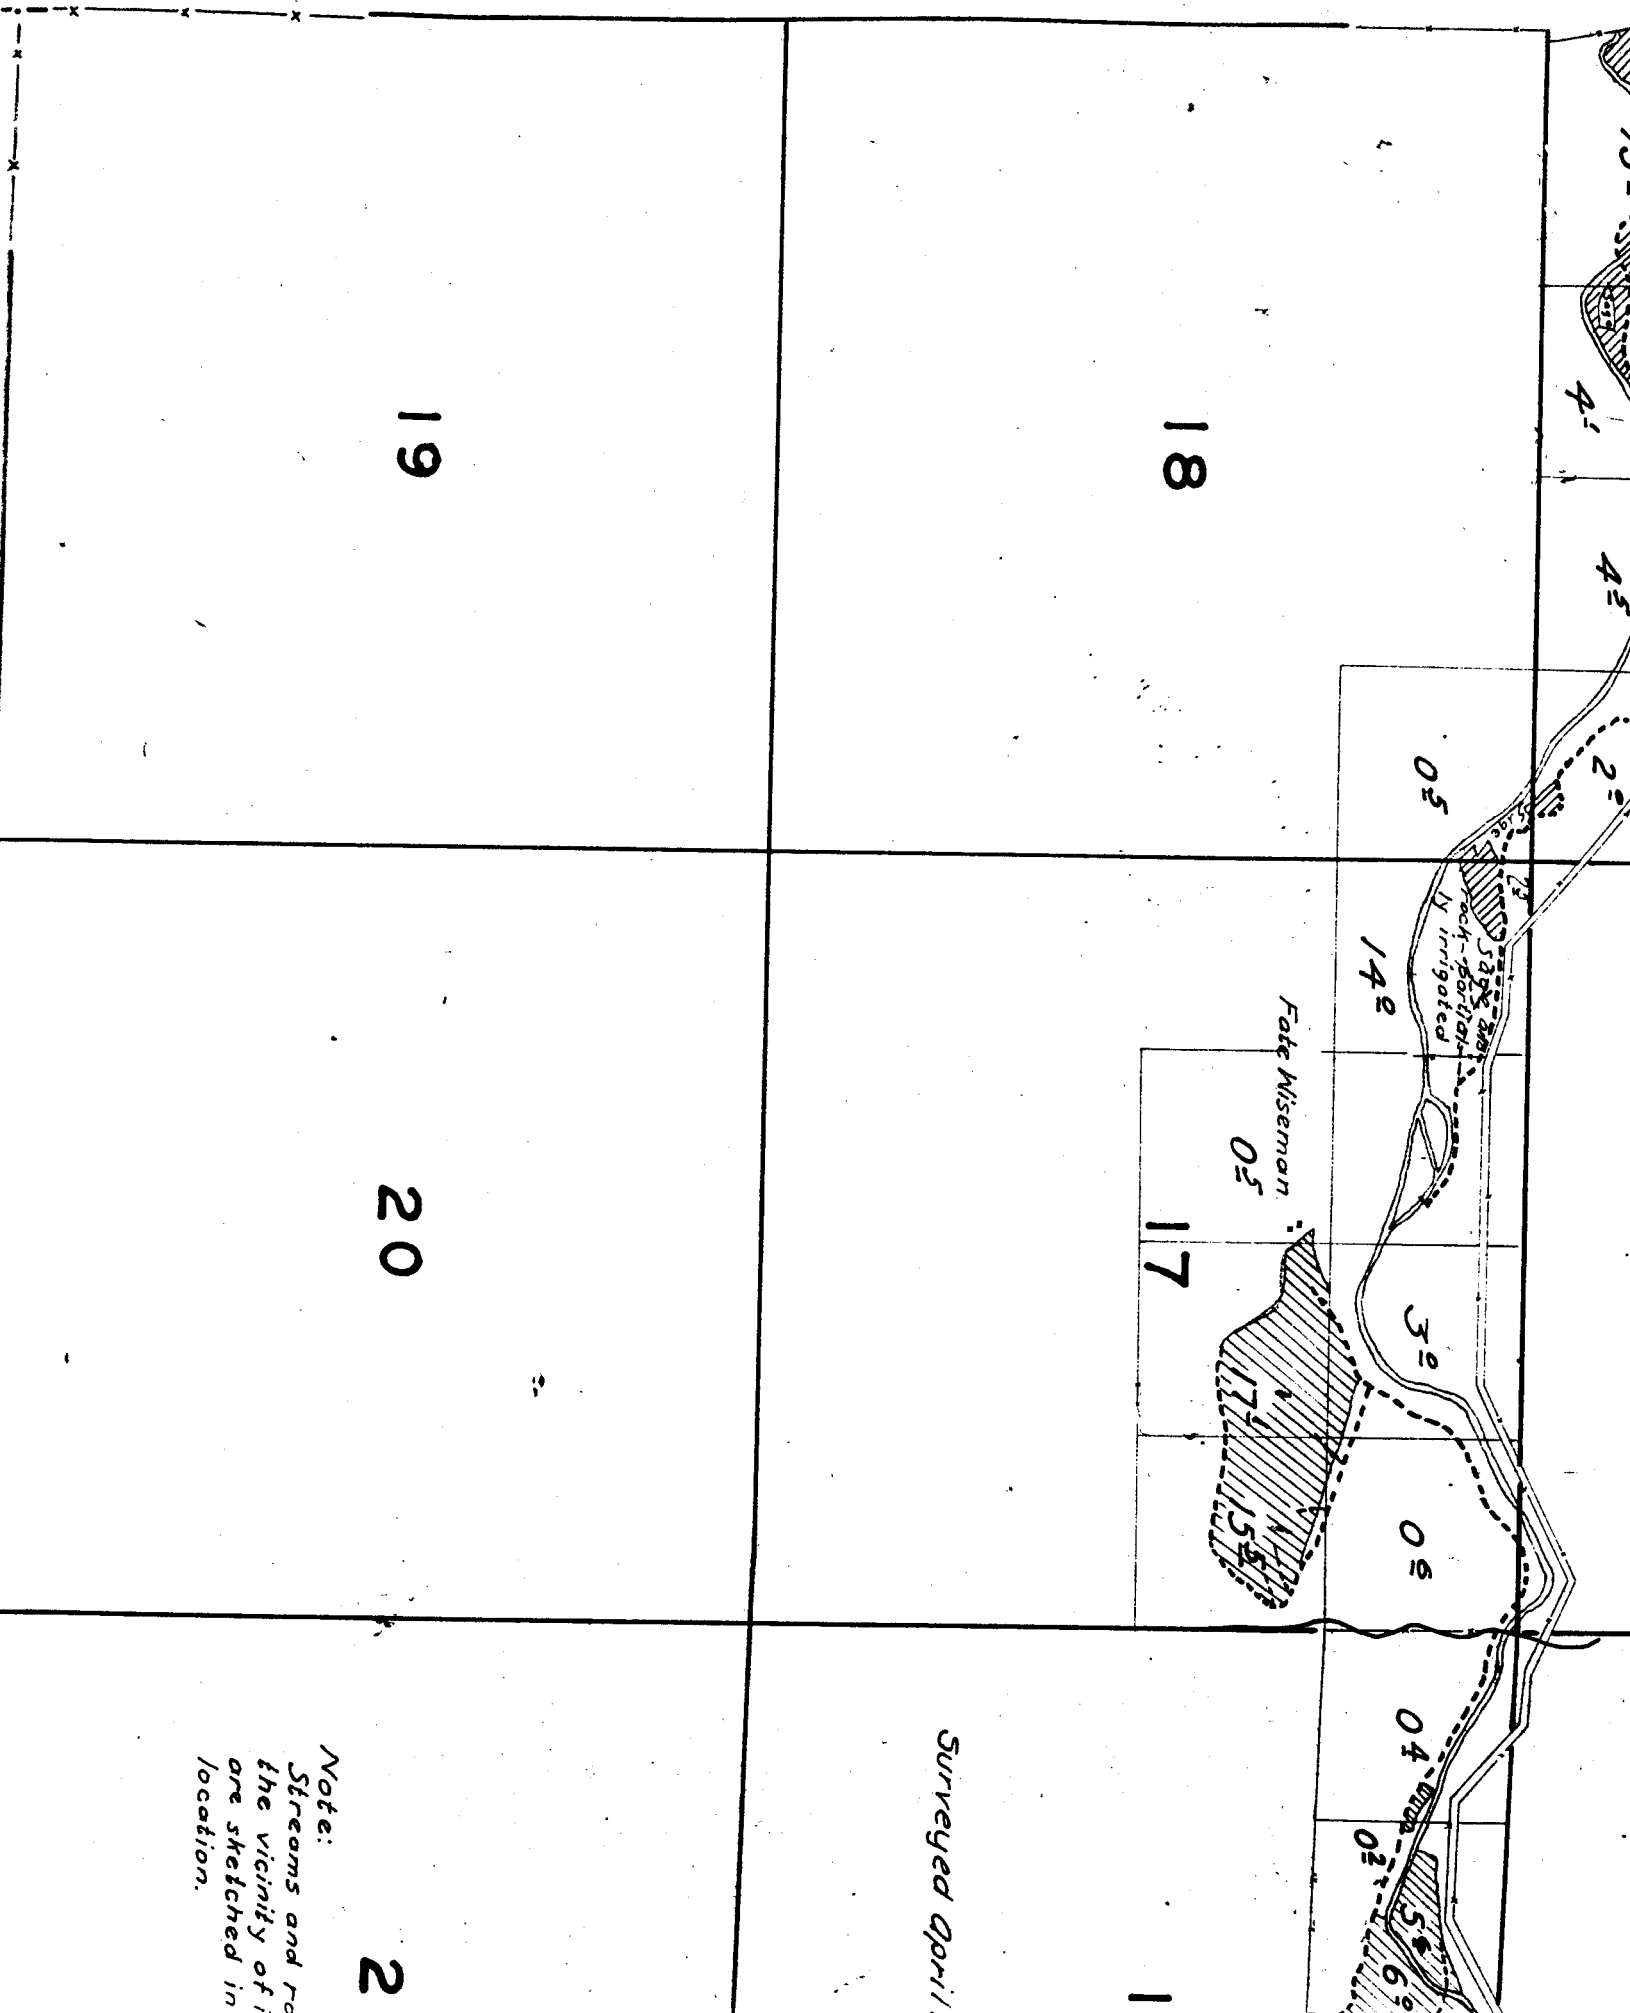

Surveyed April

Note:
Streams and roads
in the vicinity of
are sketched in
location.

2

