


T.26S., R.30E., W.M.

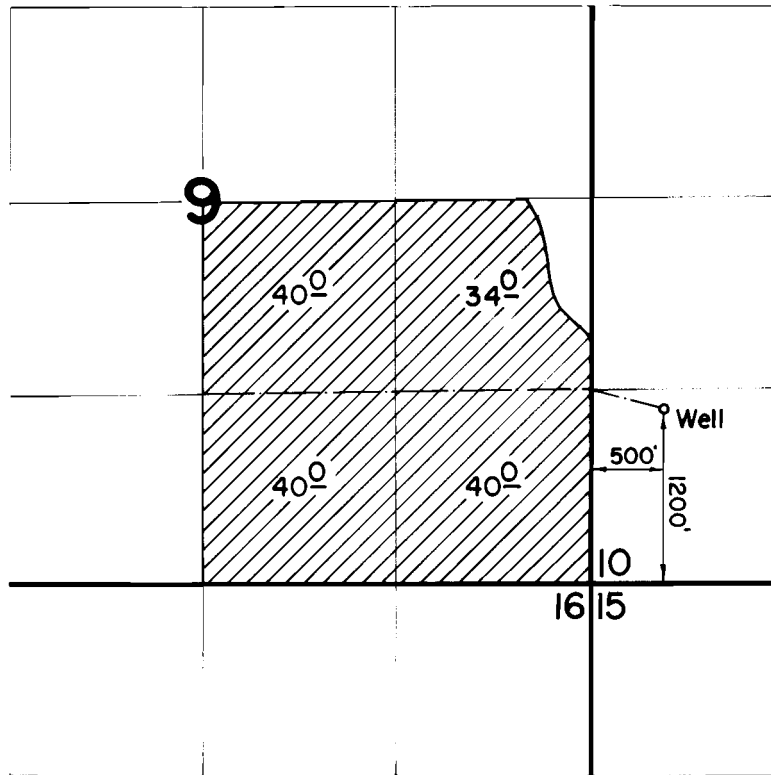

FINAL PROOF SURVEY UNDER

Application No. G-5345 Permit No. G-5287
IN NAME OF

CLIFFORD FINE

Surveyed April 23, 1976, by D. Norby