


T.23S., R.32 1/2E., W.M.

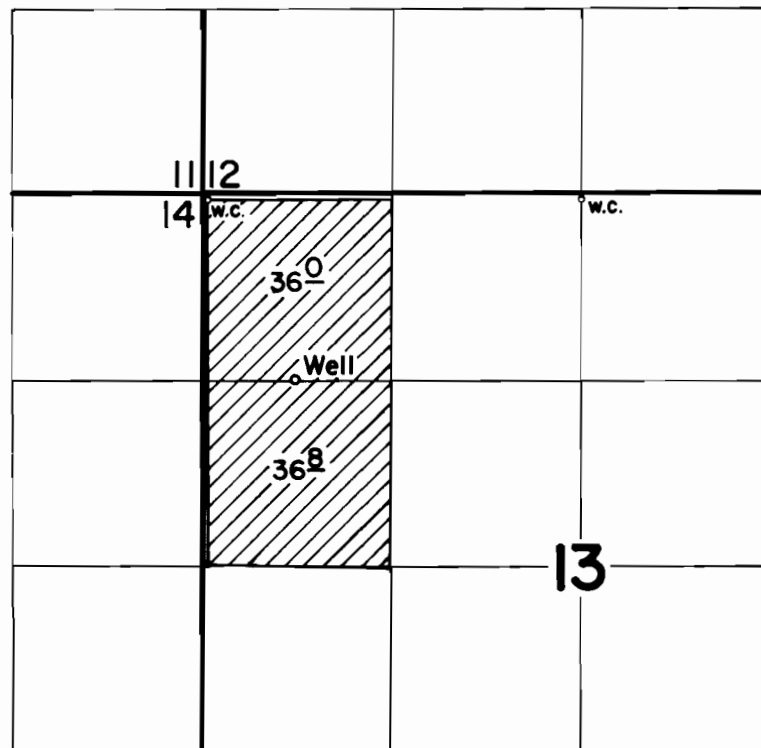

WELL LOC: 1290' S & 630' E FROM NW COR. SEC. 13

FINAL PROOF SURVEY
UNDER

Application No. G-5950 Permit No. G-5648
IN NAME OF

NORMAN T. AARTUN

Surveyed April 24 1976, by D. Norby