


T.23S., R.30E., W.M.

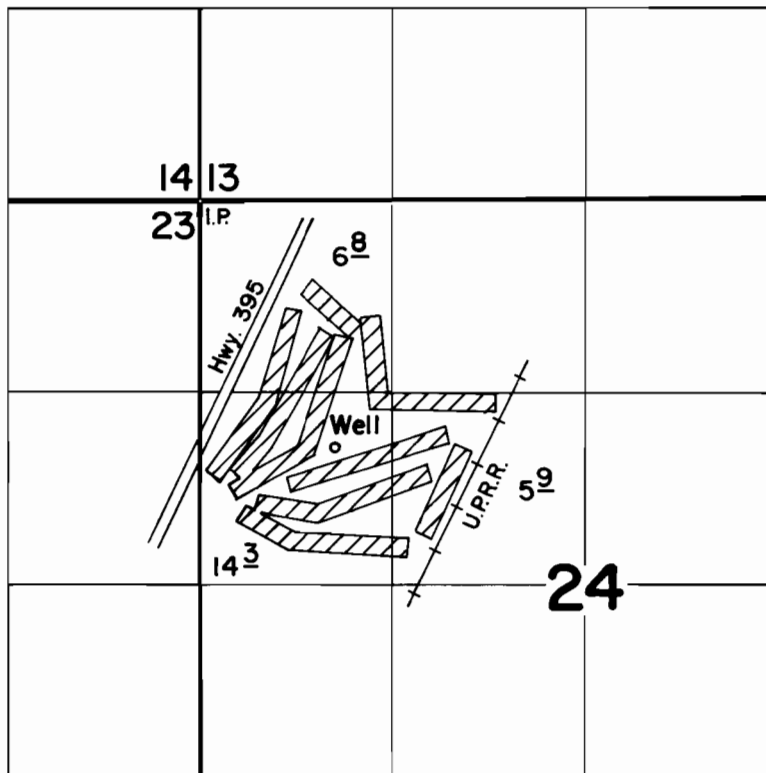

WELL LOC: 1700' S & 930' E FROM NW COR. SEC. 24

FINAL PROOF SURVEY UNDER

Application No. G-6759 Permit No. G-6279
IN NAME OF

VALLEY GOLF CLUB

Surveyed April 21 1976, by D. Norby