T.1S.R.9&10E. W.M.

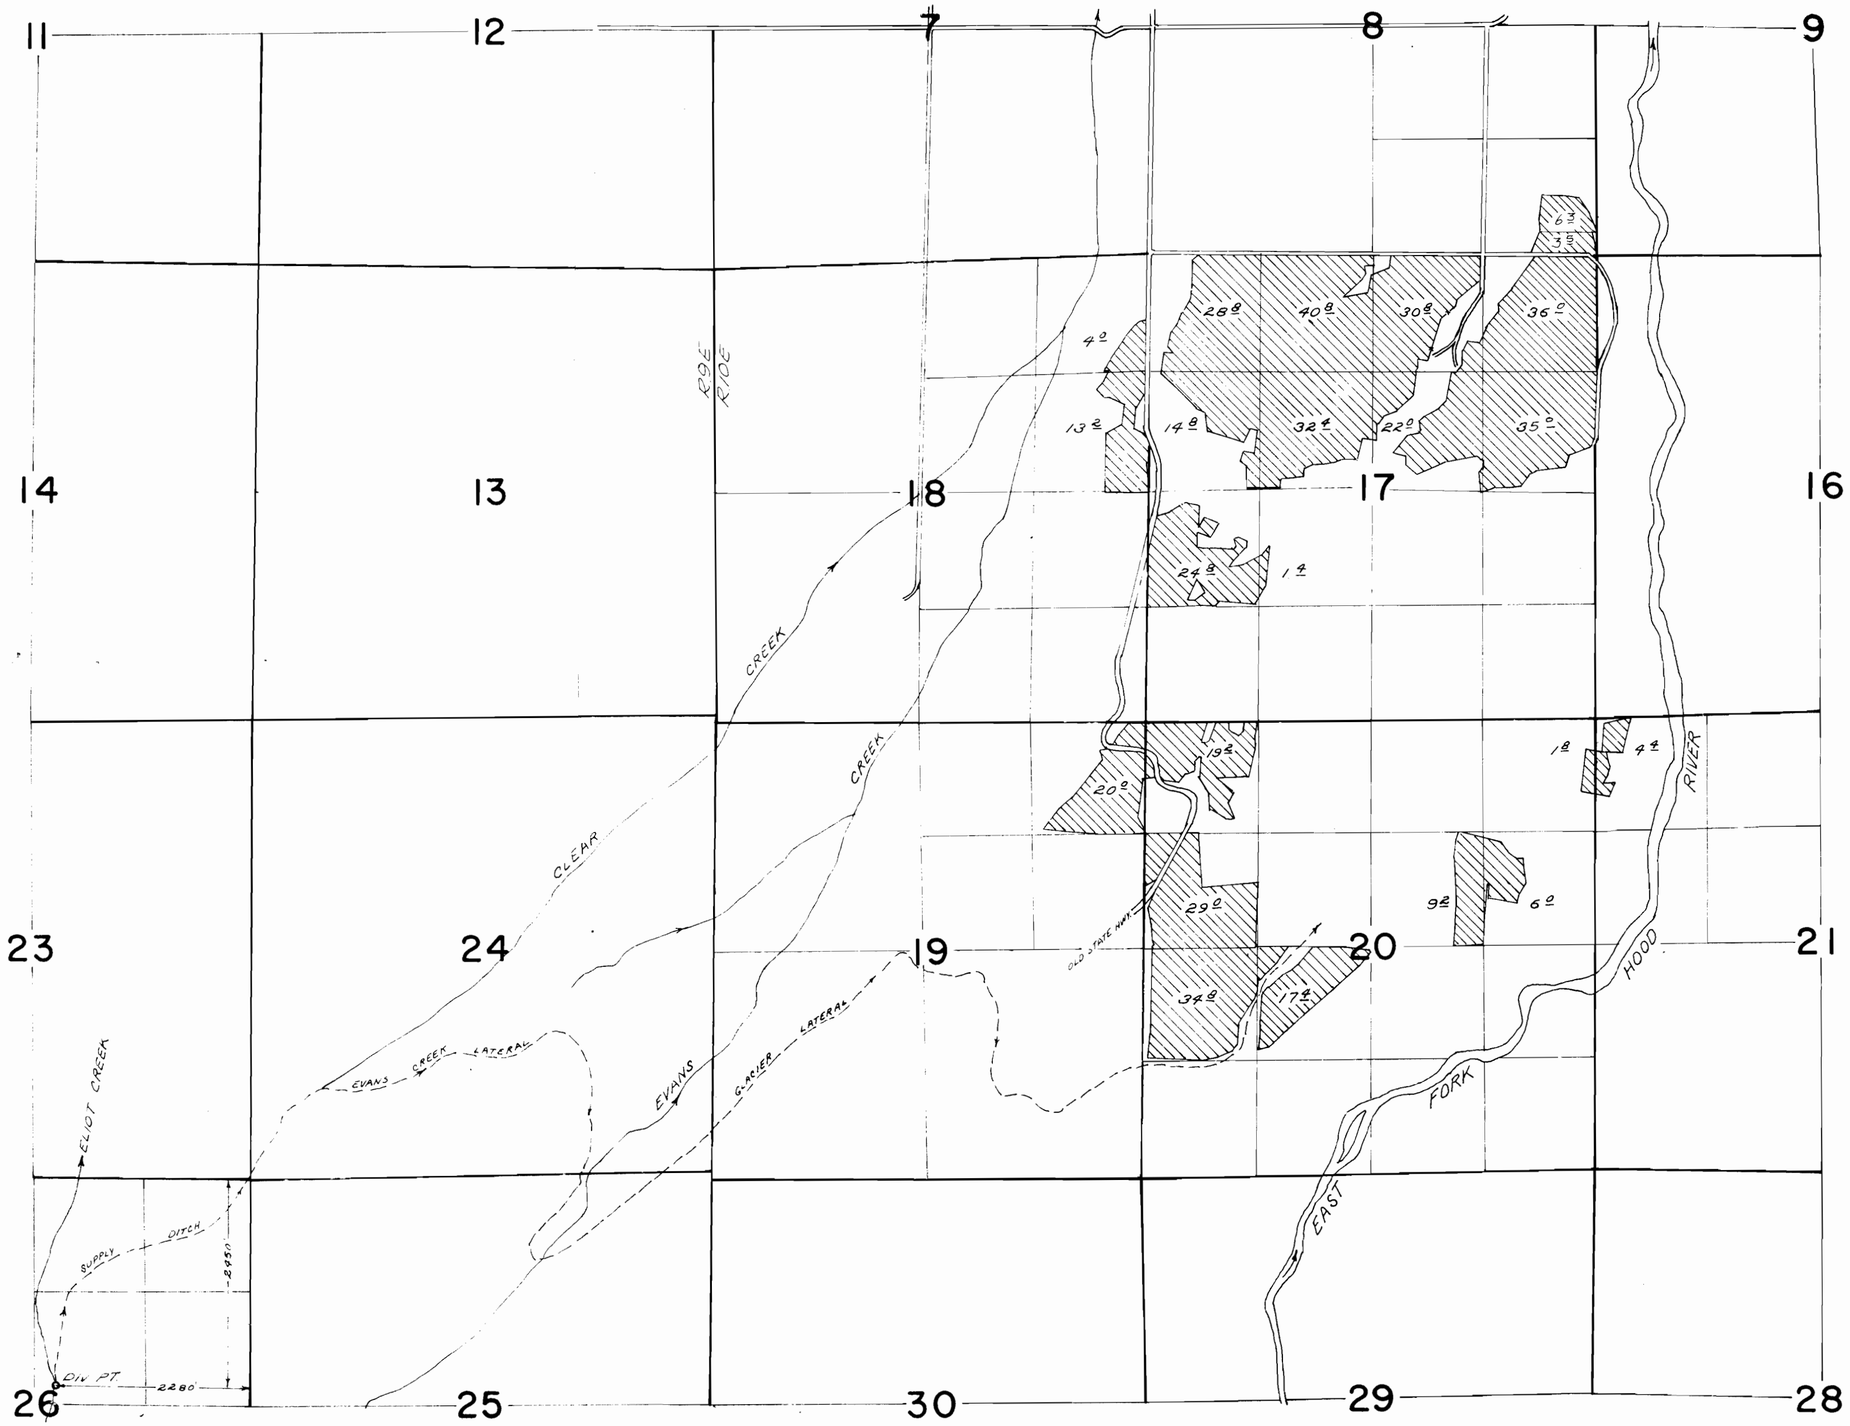

FINAL PROOF SURVEY

UNDER

Application No. 23595, Permit No. 23660

IN NAME OF

MIDDLE FORK IRRIGATION DISTRICT

1963 Hood River Inchoate Survey