


T.1S. R.9E. W.M.

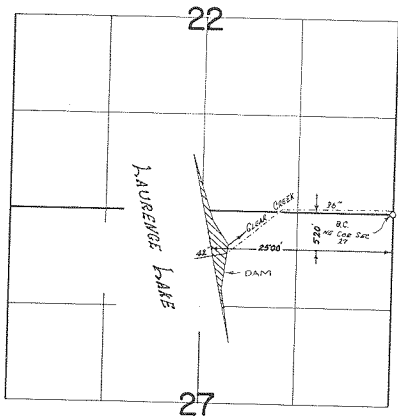


**FINAL PROOF SURVEY**  
UNDER

Diversion Point From Clear Creek  
Application No. .... Permit No. ....  
IN NAME OF

MIDDLE FORK IRRIGATION DISTRICT

Surveyed Sep. 18. 1975, by T. PAUL .....

T.1S. R.9E.10E. W.M

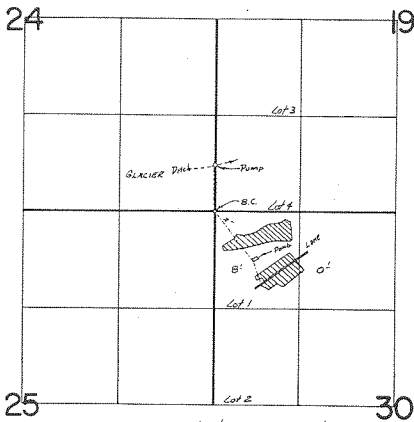

ELIOT CREEK DIV. PT. 2400'S. 125'E. FROM N 1/4 COR. SEC. 24  
 T.1S. R.9E. W.M.  
 CLEAR CREEK DIV. PT. 520'S. 2500'W. FROM N.E. COR. SEC. 27  
 T.1S. R.9E. W.M.

FINAL PROOF SURVEY  
 UNDER

Application No. 45717..... Permit No. .34104..  
 IN NAME OF

MIDDLE FORK IRRIGATION DISTRICT

Surveyed June..19. 1975, by T. PAUL.....