


G-5897

46276

T. 39 S., R. 8 E., W.M.

29

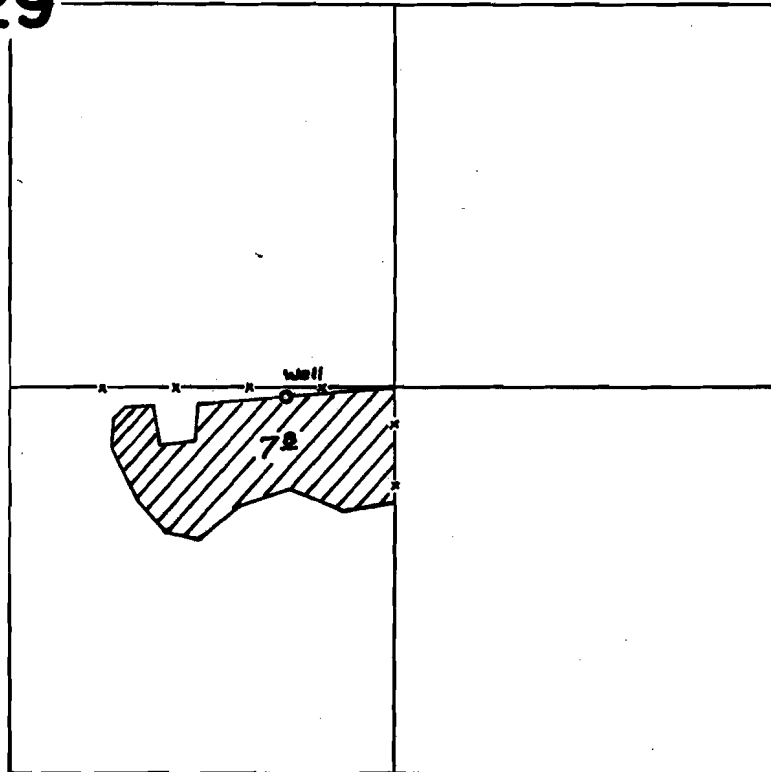

Well located: 35' S & 375' W from the NE cor. of the SW 1/4 SE 1/4

SCALE: 1" = 660'

FINAL PROOF SURVEY UNDER

Application No. G-6260 Permit No. G-5897
IN NAME OF

M. A. GURNEY

Surveyed JUNE 12, 1976, by D. NORBY

Klamath Av. wells