


T.40S.R.20E.W.M.

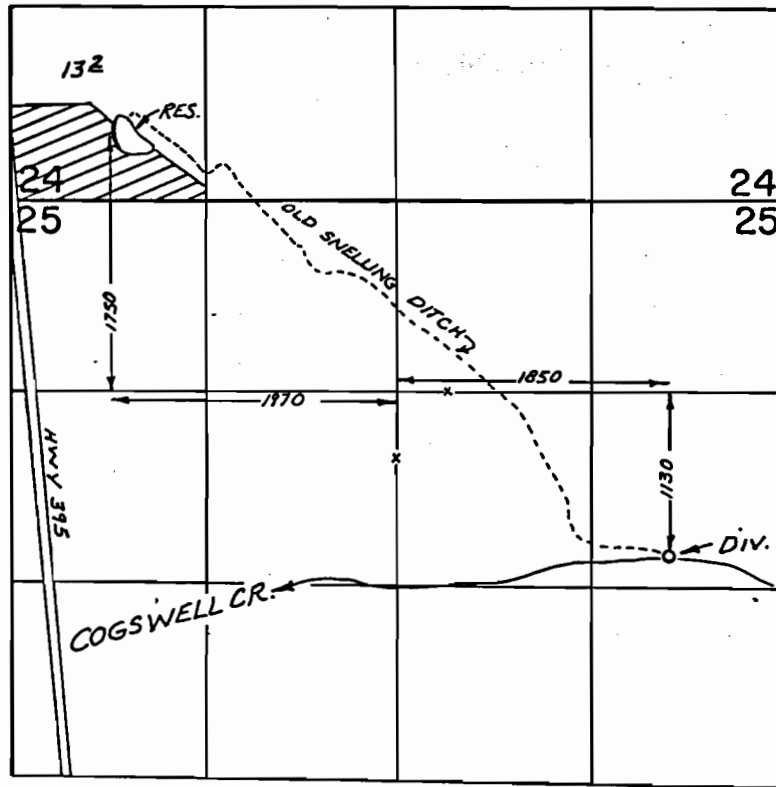

FINAL PROOF SURVEY
UNDER

Application No. *R-50402* Permit No. *R-6204*
50999 *38494*
IN NAME OF

ERNEST T. FETSCH

Surveyed *OCT. 21, 1976.* by *R. MUCKEN*