


**T.18S., R.5W., W.M.**  
**SECTION 7**

*County Rd. #803*

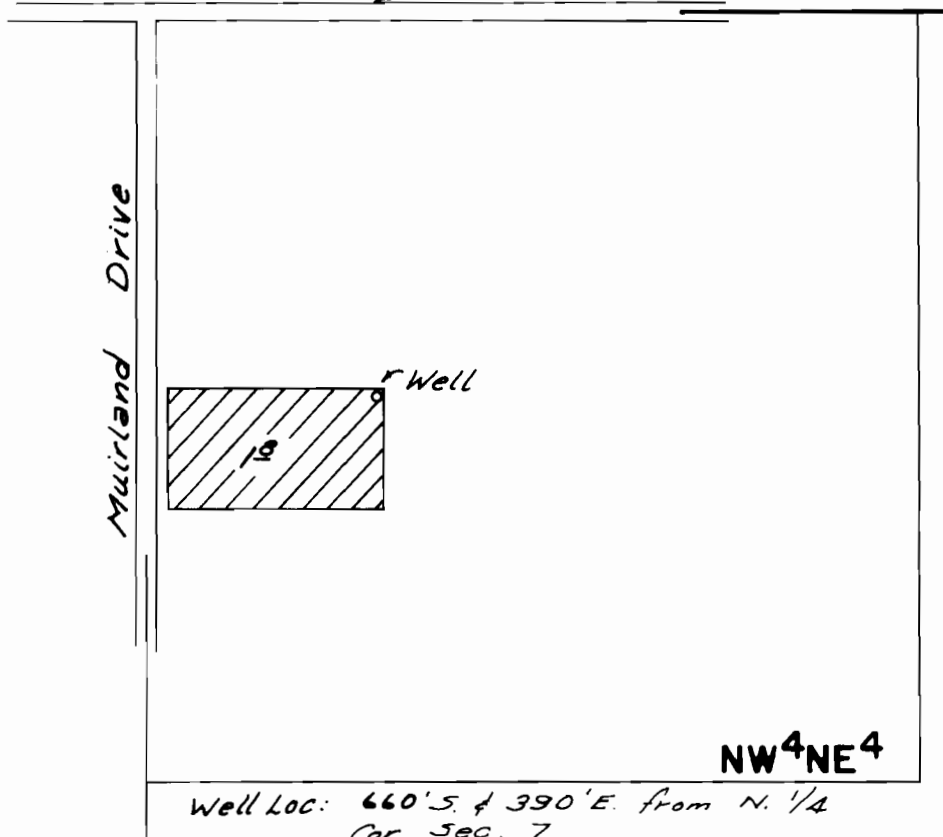

SCALE 1" = 330'

**FINAL PROOF SURVEY**  
**UNDER**

Application No. G-5798 Permit No. G-5563  
IN NAME OF

Roland B. & Linda M. Anderson

Surveyed May 13, 1976 by D.M. Norby

PTS-1976-A *dlb*