


# T. 15 S., R. 4 W., W.M.

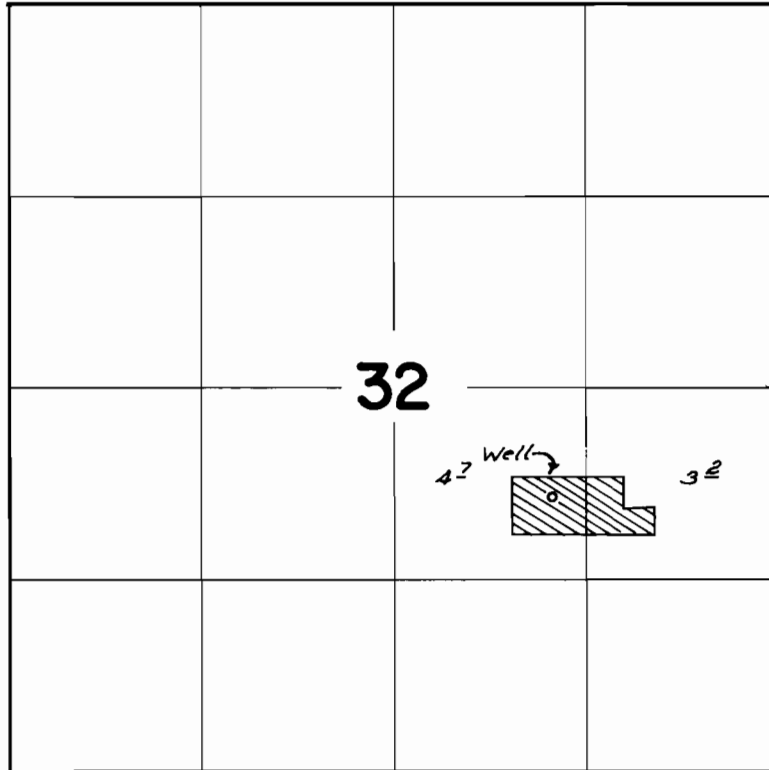

Well Loc.: 1880' N. & 1560' W. from S.E. Cor. Sec. 32

## FINAL PROOF SURVEY UNDER

Application No. G-6334 Permit No. G-5942  
IN NAME OF

James R. Siddle

Surveyed May 10 1976, by D.M. Norby

DBQ-111-269

*SCB*