


T. 15 S., R. 6 W., W.M.

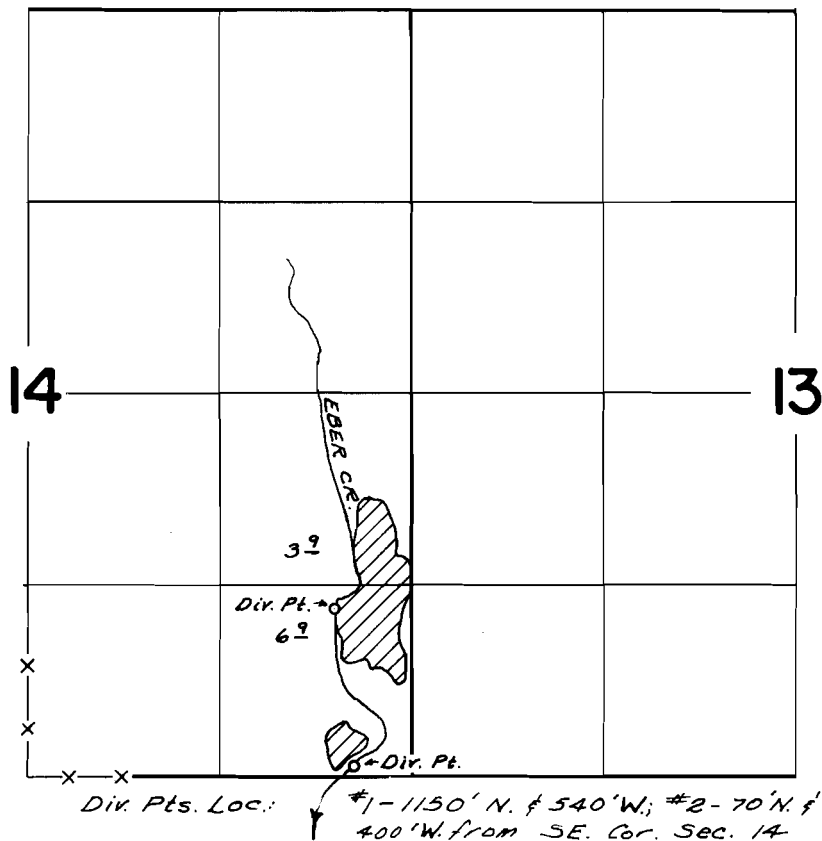

FINAL PROOF SURVEY
UNDER

Application No. 44129 Permit No. 32960
IN NAME OF

James Allen Evans

Surveyed May 19, 1976, by D.M. Norby