


T. 18 S., R. 5 W., W.M.

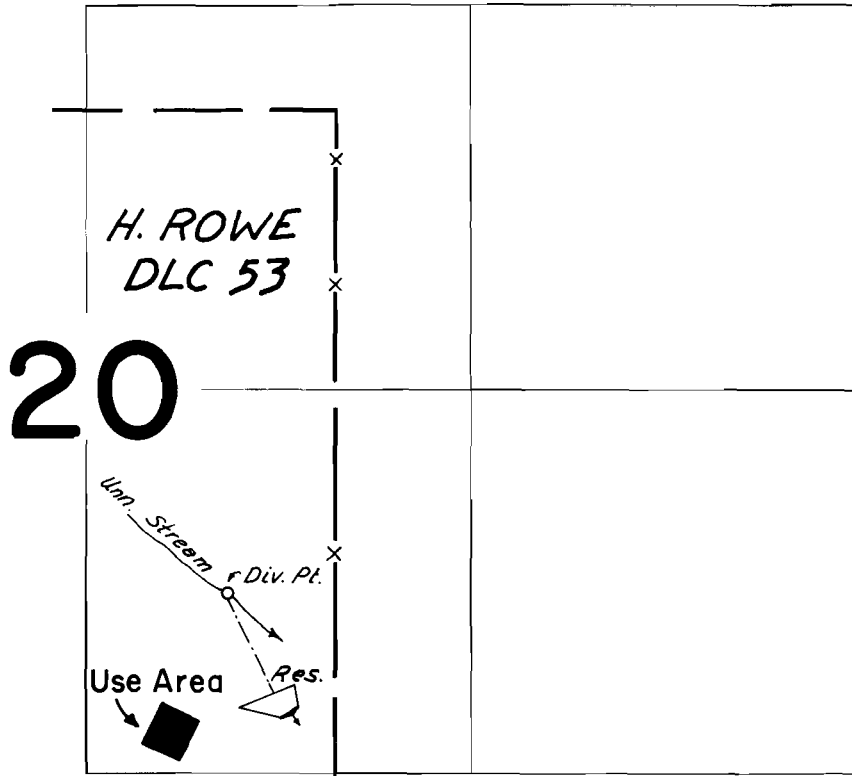

Div. Pt. Loc.: 1650' S. & 370' W. from NE Cor DLC 53

SCALE 1" = 660'

**FINAL PROOF SURVEY**  
UNDER

R-47891                      R-5796  
Application No. 47892    Permit No. 35886  
IN NAME OF

Crow High School

Surveyed May 13, 1976, by D. M. Norby