




T.18S.R.10W.W.M.

Application No. 48988
Permit No. 36676

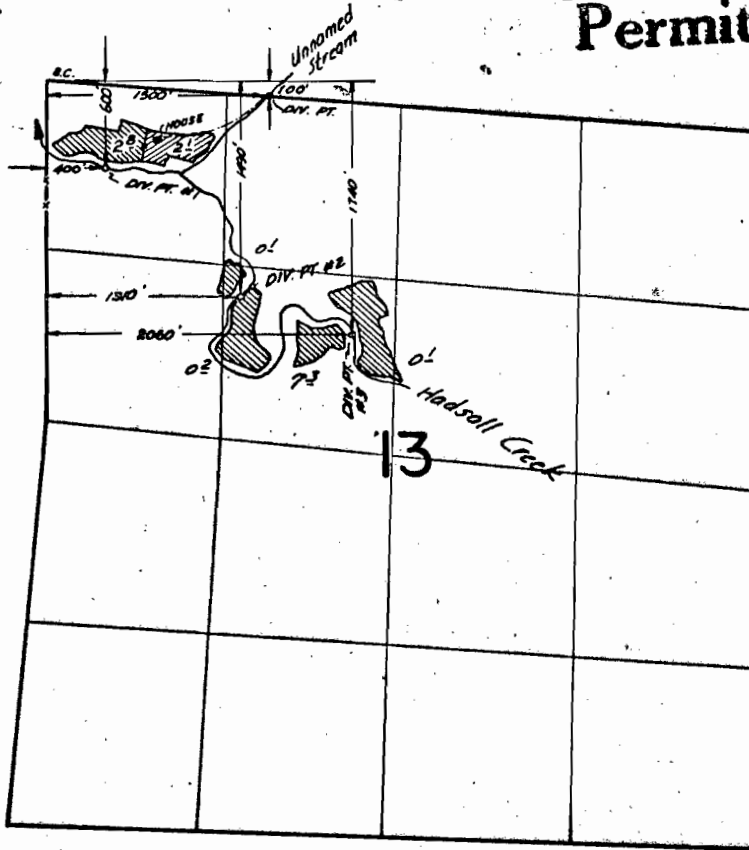

 from unnamed stream
 from Hadsall Creek

RECEIVED
 FEB 9 1972
 STATE ENGINEER
 SALEM OREGON

FINAL PROOF SURVEY
UNDER

Application No. 38292 Permit No. 28523
IN NAME OF

IVAN W. & IONE REED

Surveyed March 21 1970, by V.R. Garner

File copy