


T.16S.,R.2W.,W.M.

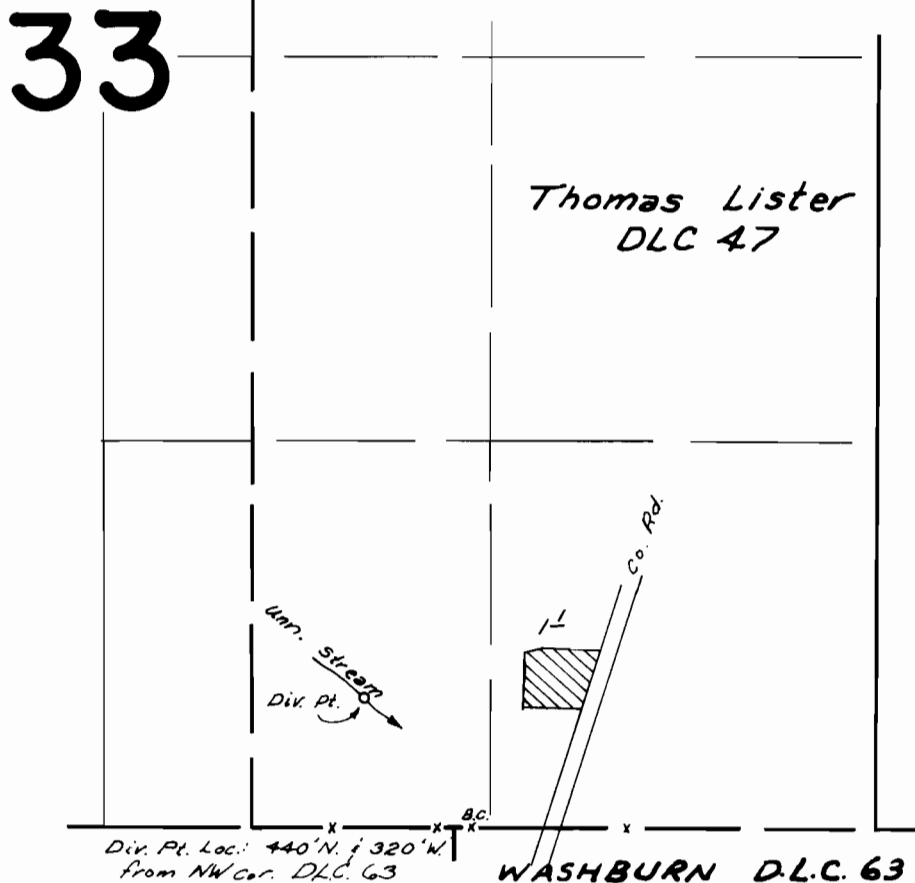

Scale: 1" = 660'

FINAL PROOF SURVEY
UNDER

Application No. 49167 Permit No. 36723
IN NAME OF

Donald J. & Jennifer S. Wouda

Surveyed Oct 26, 1976 by D.M. Norby

PTS-1976-C

JB