


T.21S.,R.3W.,W.M.

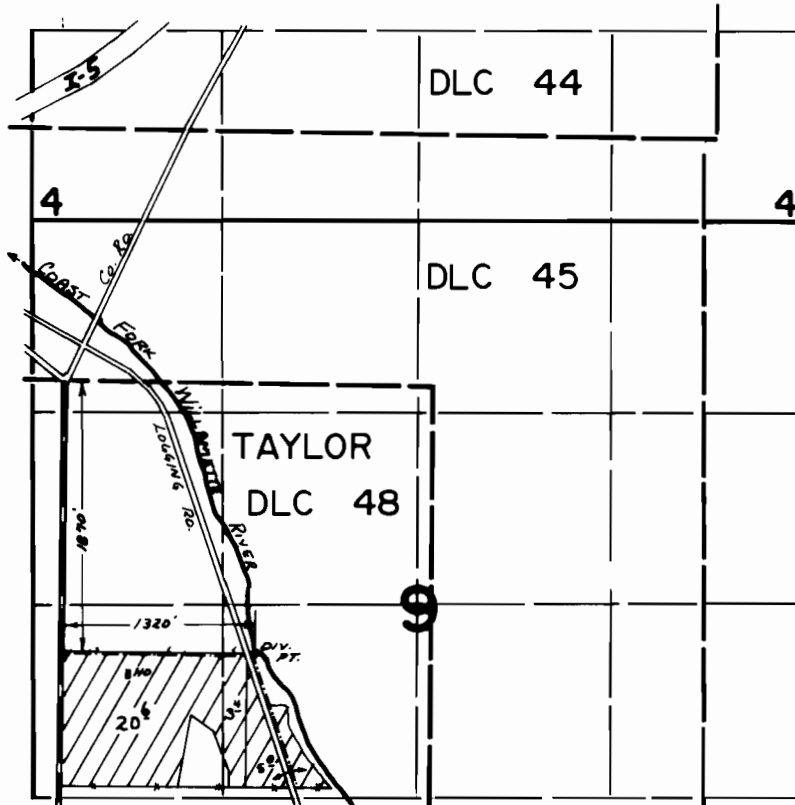

**FINAL PROOF SURVEY**  
UNDER

Application No. 49349.. Permit No. 36995..  
IN NAME OF

CLAUDE & JUANITA HENSLEY..

Surveyed JUNE 15, 1976, by L. TOLL.....