


T. 15 S., R. 1 W., W.M.

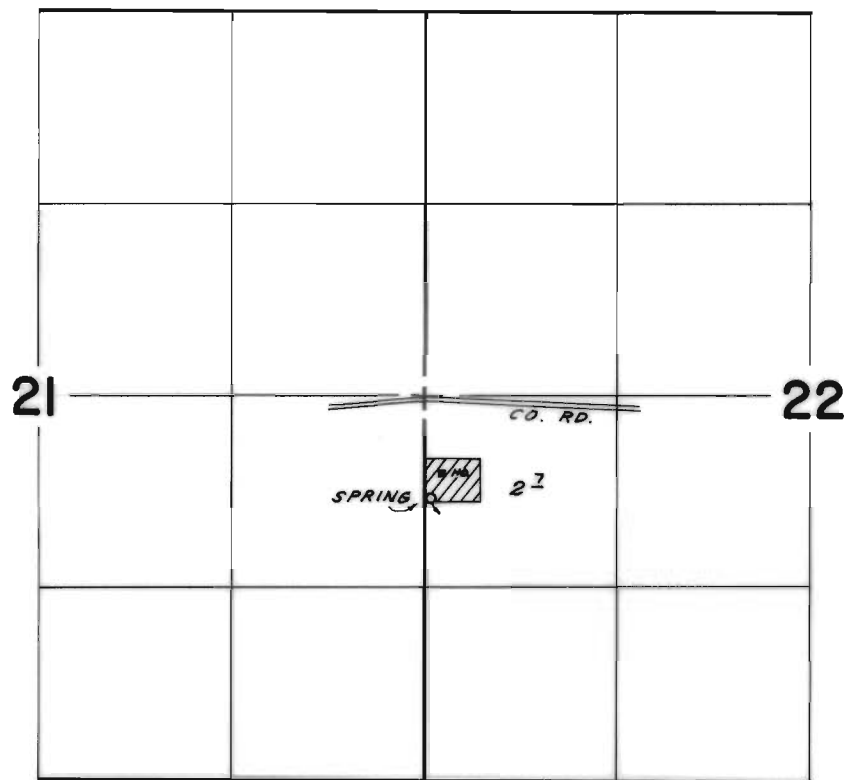

SPRING LOC.: 710' S. & 30' E. of W. $\frac{1}{4}$ COR. SEC. 22

FINAL PROOF SURVEY
UNDER

Application No. 49533 Permit No. 37075
IN NAME OF

Robert Dwane Nelson

Surveyed Oct. 27, 1976, by D. M. NORBY