


T. 15 S., R. 5 W., W.M.

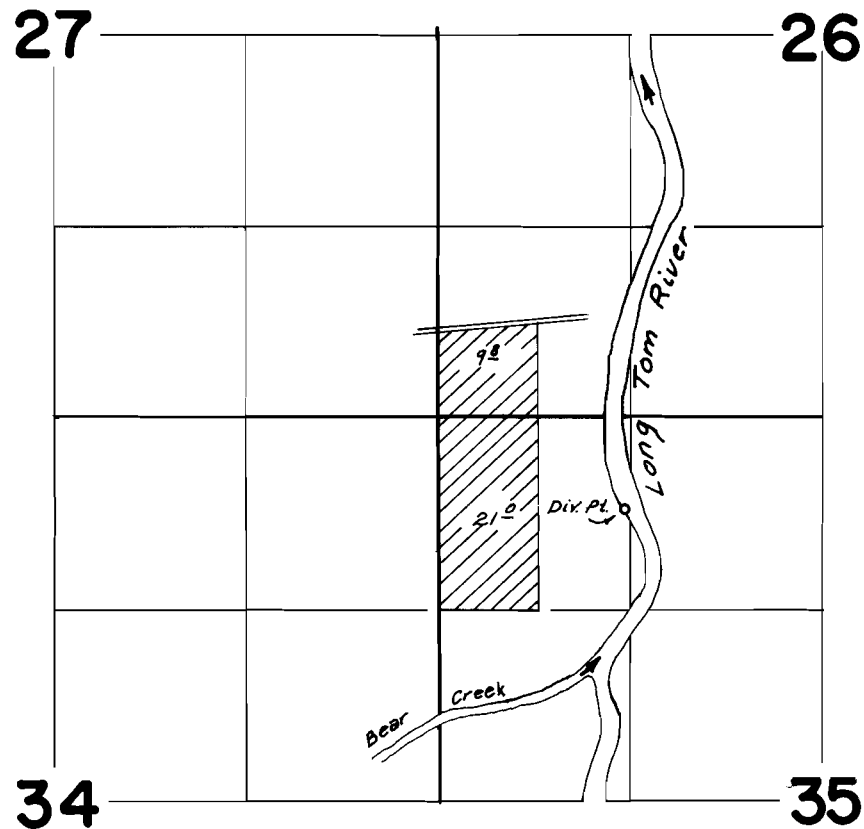

Div. Pt. Loc.: 630' S. & 1280' E. from NW Cor. Sec. 35.

FINAL PROOF SURVEY
UNDER

Application No. 49998 Permit No. 37946
IN NAME OF

Brockner Mikkelsen

Surveyed May 10 1976, by D.M. Norby

DBQ-100-202

DB