


T. 15S., R. 4W., W.M.

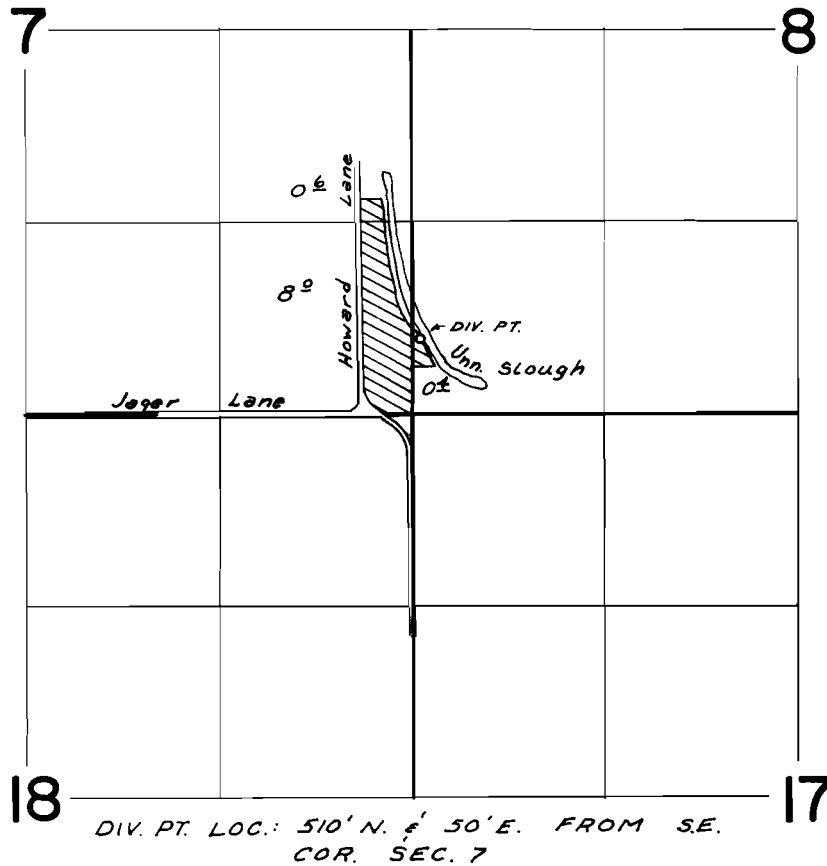

FINAL PROOF SURVEY UNDER

Application No. 50651 Permit No. 38267
IN NAME OF

Hurley Lee Heckart

Surveyed May 11 1976, by D.M. Norby