


T. 16 S., R. 6 E., W.M.

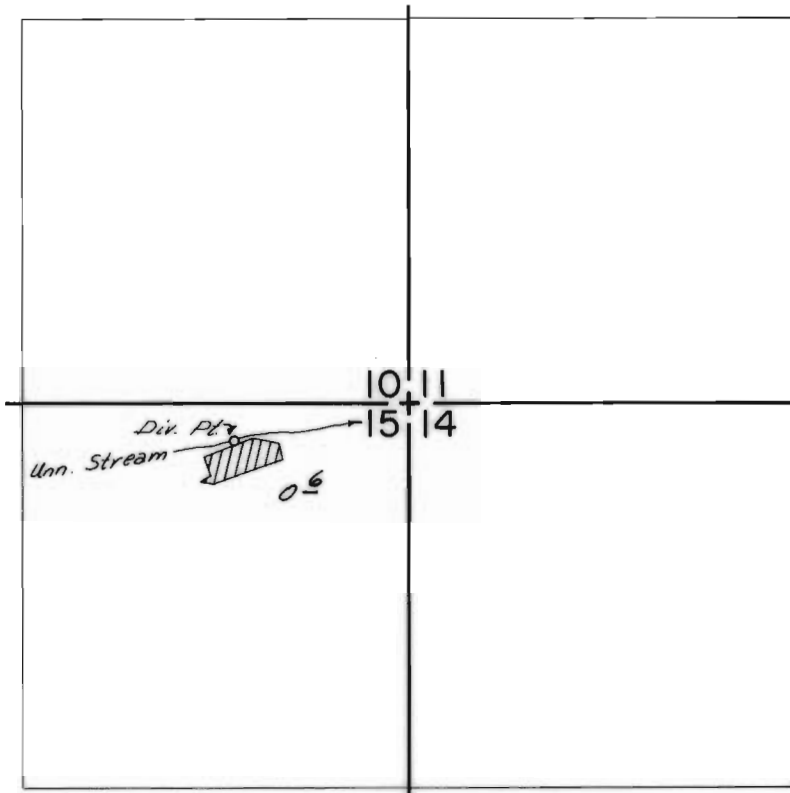

DIV. PT. LOC.: 130' S. & 600' W. From NE Cor. Sec. 15

SCALE 1" = 660'

FINAL PROOF SURVEY
UNDER

Application No. 50835 Permit No. 38382
IN NAME OF

James D. Yale

Surveyed May 25, 1976, by D. M. Norby