


T. 16 S., R. 2 W., W.M.

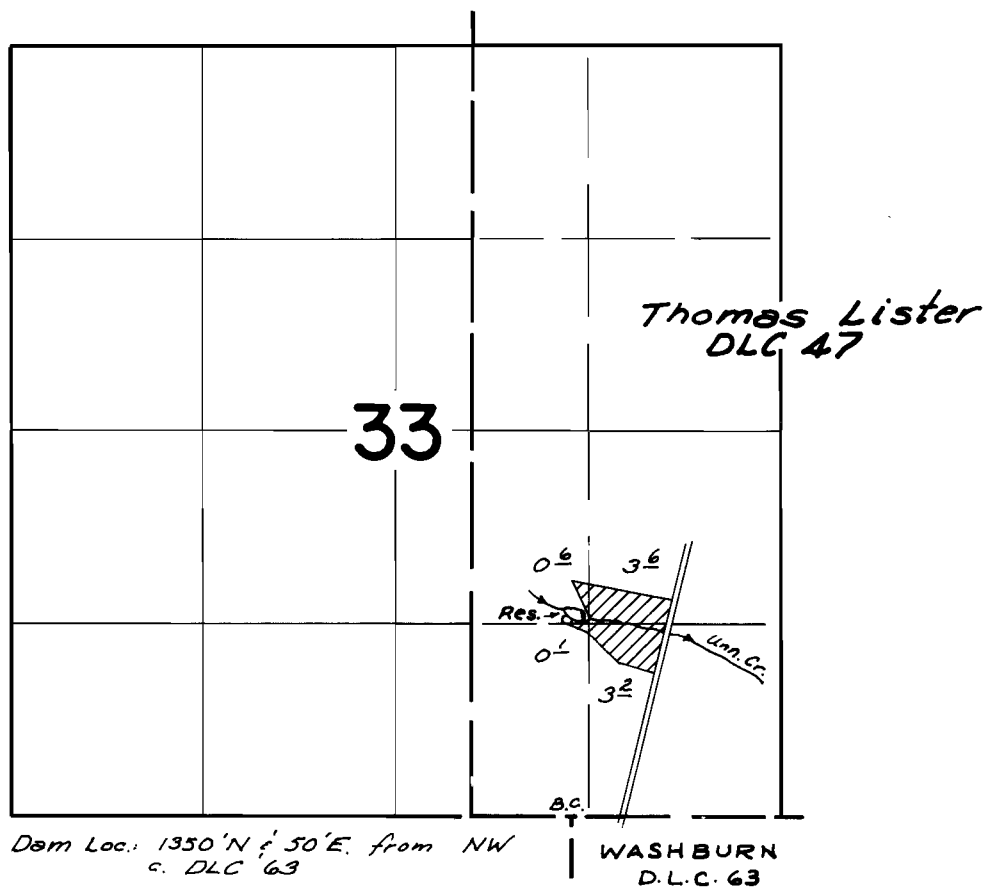

FINAL PROOF SURVEY
UNDER

R-51916 R-6252
Application No. 51917 Permit No. 39061
IN NAME OF

Roger A. Fox

Surveyed Oct. 27, 1976 by D.M. Norby