


T.18 S., R.1 W., W.M.

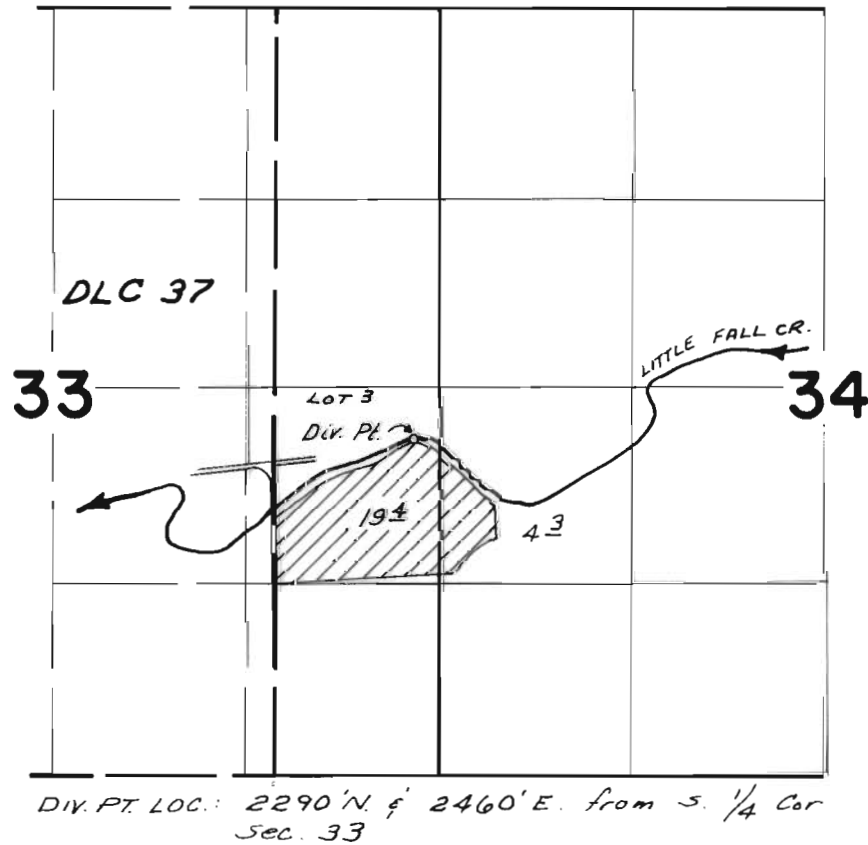

FINAL PROOF SURVEY
UNDER

Application No. 52731 Permit No. 39707
IN NAME OF

Blanch M. Coltrane

Surveyed Oct 28, 1976 by D.M. Norby