


T.6S.,R.10W.,W.M.

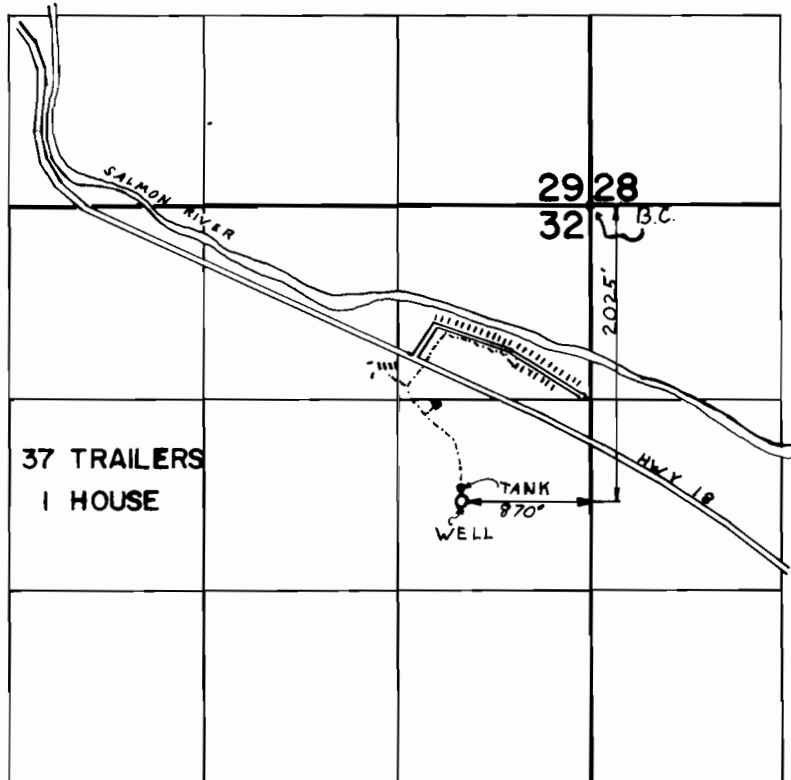

**FINAL PROOF SURVEY**  
UNDER

Application No. G-5925 Permit No. G-5632  
IN NAME OF

ELDON W. HERINGER

Surveyed JUNE 30 1976, by G.R. KING