


T.10S.R.2W.W.M.

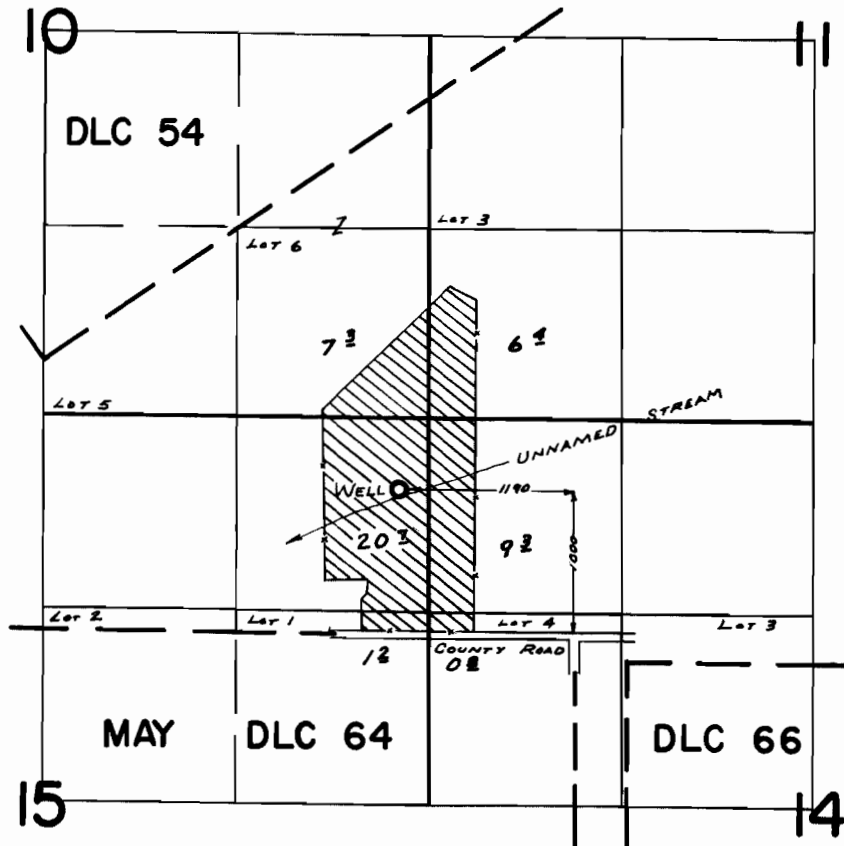

**FINAL PROOF SURVEY**  
UNDER

Application No. *G-3928* Permit No. *G-3608*  
IN NAME OF

WAYNE C. STAATS

Surveyed *MARCH 19, 1969*, by *W. RUPPERT*