


T.12S.R.2W.W.M.

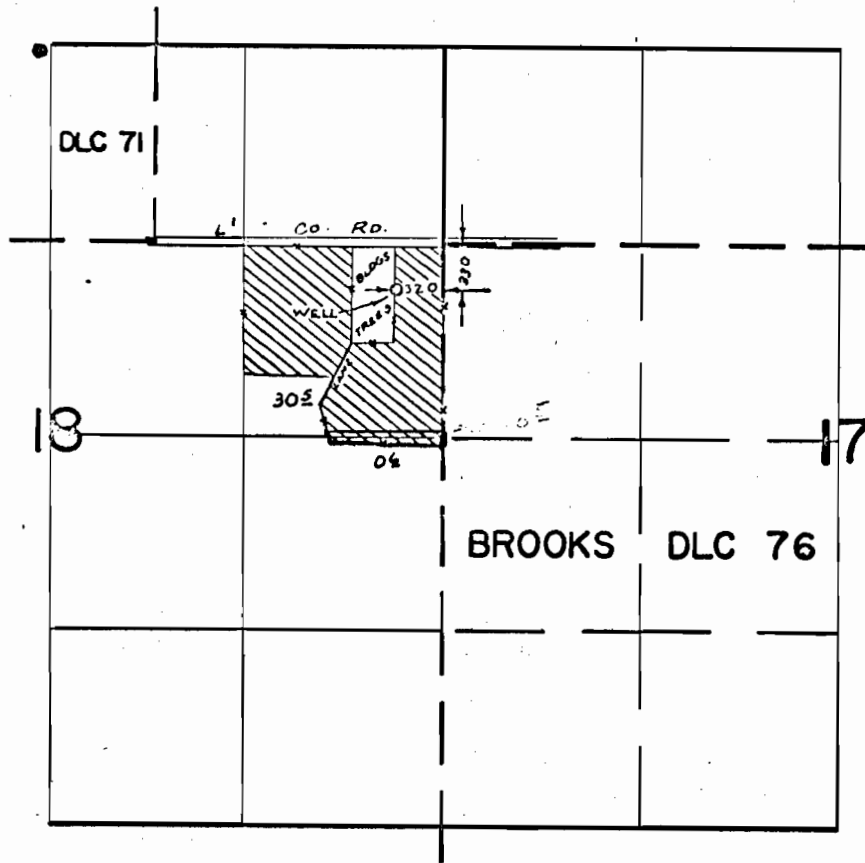

Application No. G-5731
Permit No. G 5531

FINAL PROOF SURVEY

UNDER

Application No. G-4749 Permit No. G-4468
IN NAME OF

W. E. & DOROTHY I. ROBERTS

Surveyed May 6, 1970, by R. Mucken.....