


# T.13S., R.1E., W.M.

FOSTER RESERVOIR

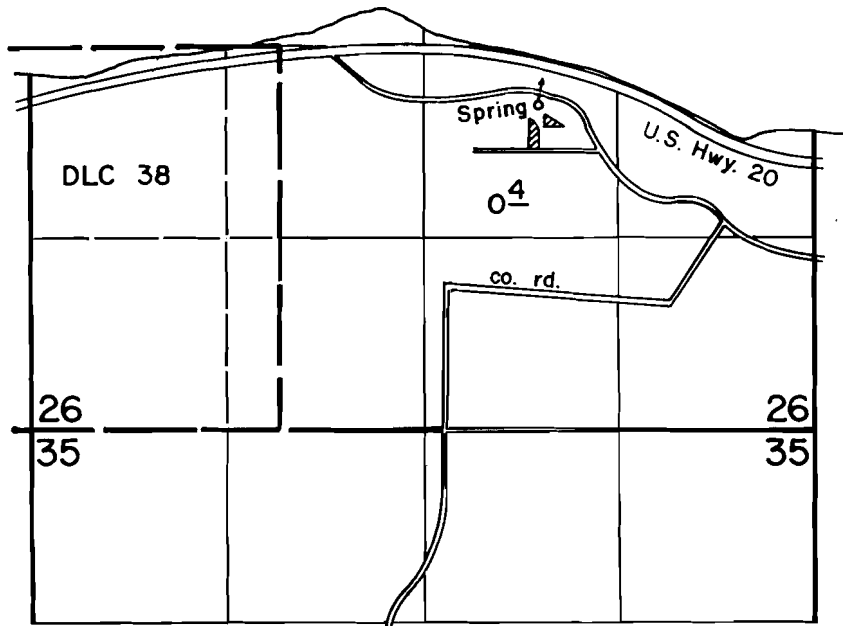

SPR. LOC: 420' S & 780' E from center section 26

## FINAL PROOF SURVEY UNDER

Application No. 48188 Permit No. 36196  
IN NAME OF

WILLIAM T. & MARTINA M. MERZENICH

Surveyed May 3 1976, by D. Norby