


T.13S., R.1E., W.M.

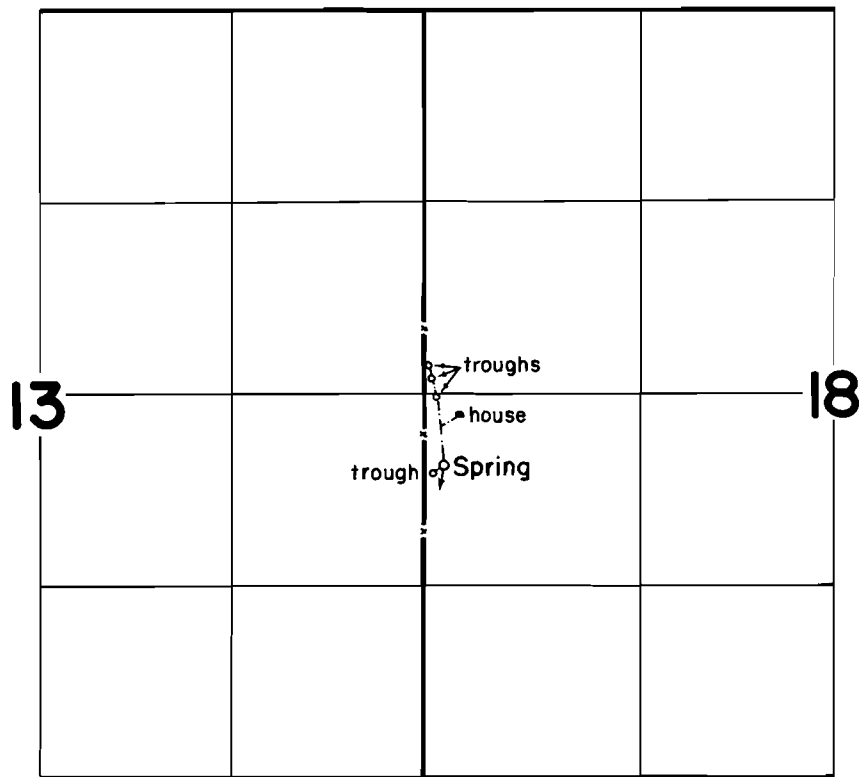

SPRING LOC: 490' S & 140' E from W 1/4 cor. sec. 18

FINAL PROOF SURVEY
UNDER

Application No. 48275 Permit No. 36258
IN NAME OF

ELBERT M. OR LAURETTA SWINK

Surveyed May 6 1976, by D. Norby