


T.13S., R.1W., W.M.

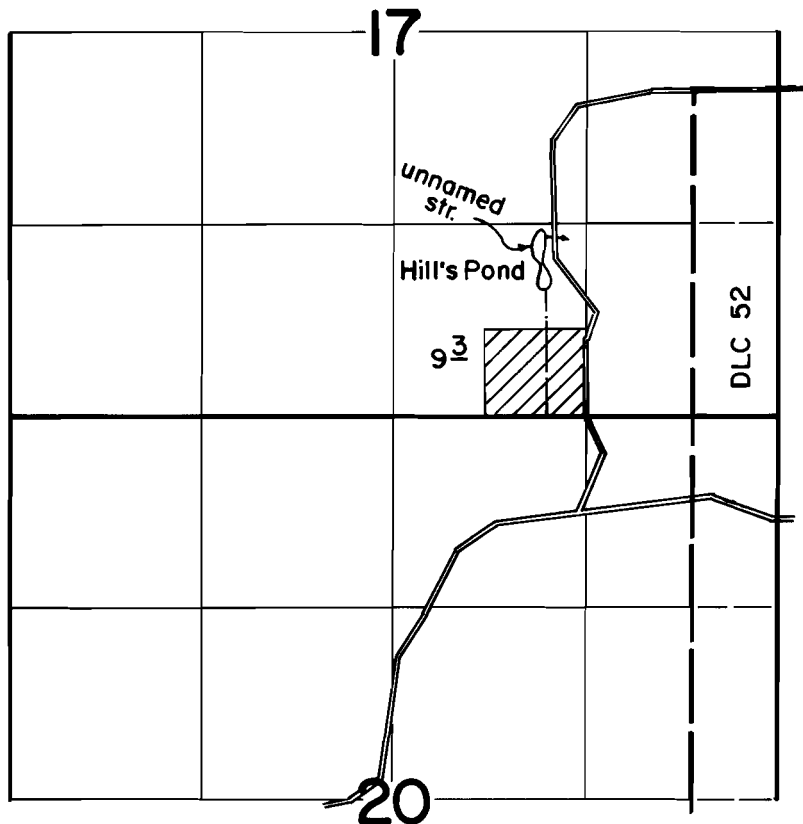

RES. LOC: 1240' N & 280' W from SE cor. SW 1/4 SE 1/4 sec. 17

FINAL PROOF SURVEY
UNDER

R-48963 R-5942
Application No. 48964 Permit No. 36665
IN NAME OF

GLENN W. & IRENE HILL

Surveyed May 4 1976, by D. Norby

W.R. 1030

GLENN W. & IRENE HILL

SEC. 17, T. 13 S., R. 1 W., W.M.

LINN COUNTY, OREGON

Scale: 1" = 10 Chains

January 25, 1972


Orris A. Carnegie

County Surveyor

RECEIVED

FEB 24 1972

STATE ENGINEER
SALEM, OREGON

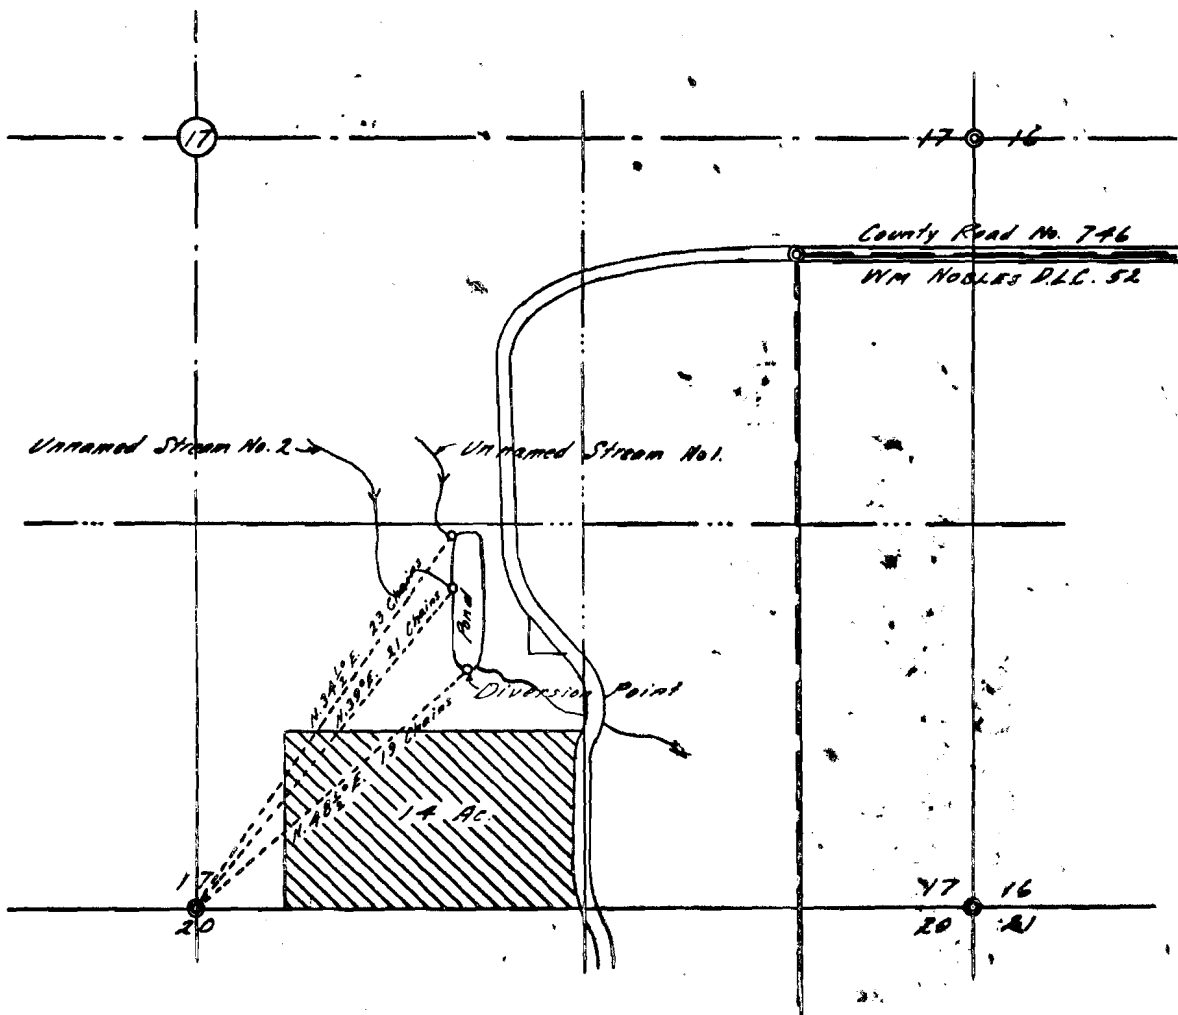

*This map drawn from County Records and
air photos.*

Application No.

Permit No.

P 48963
48964

R-5942

36665

REGISTERED
PROFESSIONAL
LAND SURVEYOR

Orris A. Carnegie

OREGON
MAY 9, 1947
ORRIS A. CARNEGIE