


T.13S., R.1E., W.M.

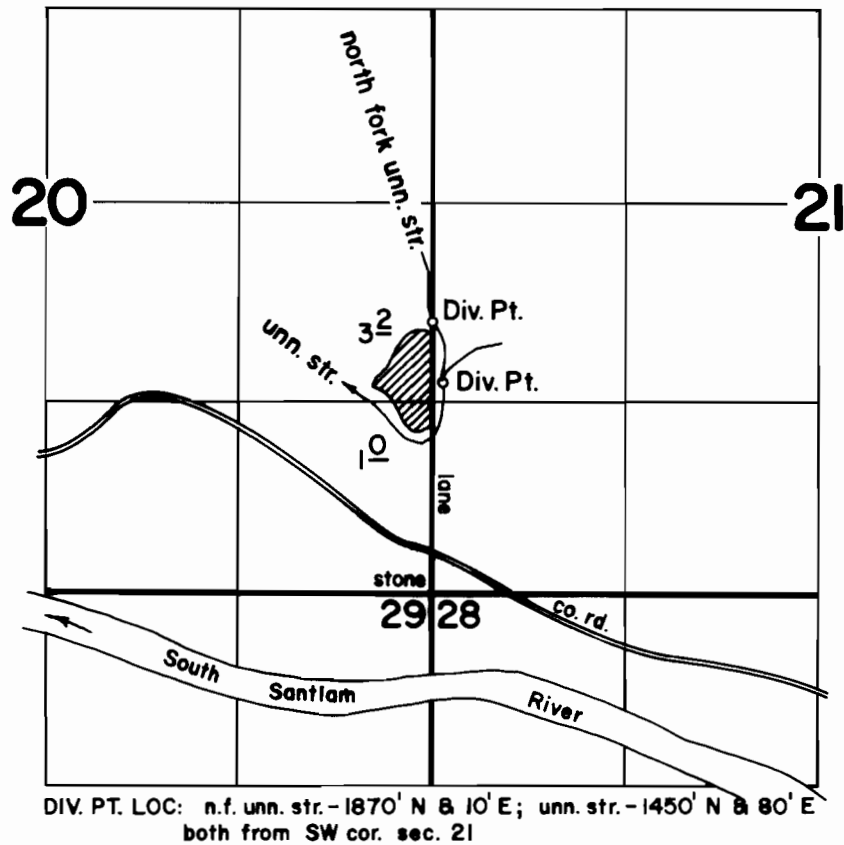

FINAL PROOF SURVEY
UNDER

Application No. 49221 Permit No. 36895
IN NAME OF

BASIL & EDNA CALKINS

Surveyed Oct. 21 1976, by D. Norby