


T.10S., R.1W., W.M.

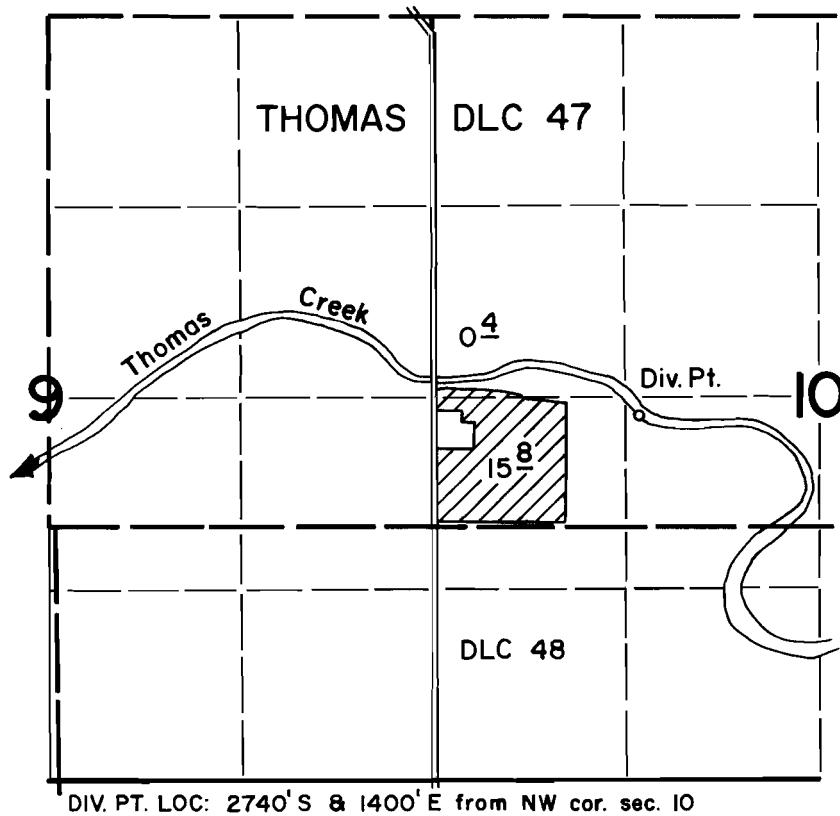

FINAL PROOF SURVEY UNDER

Application No. 50353 Permit No. 38012
IN NAME OF

JAMES A. MARESH, SR.

Surveyed Mar. 31 1976, by D. Norby