


T.I.S., R.I.W., W.M.

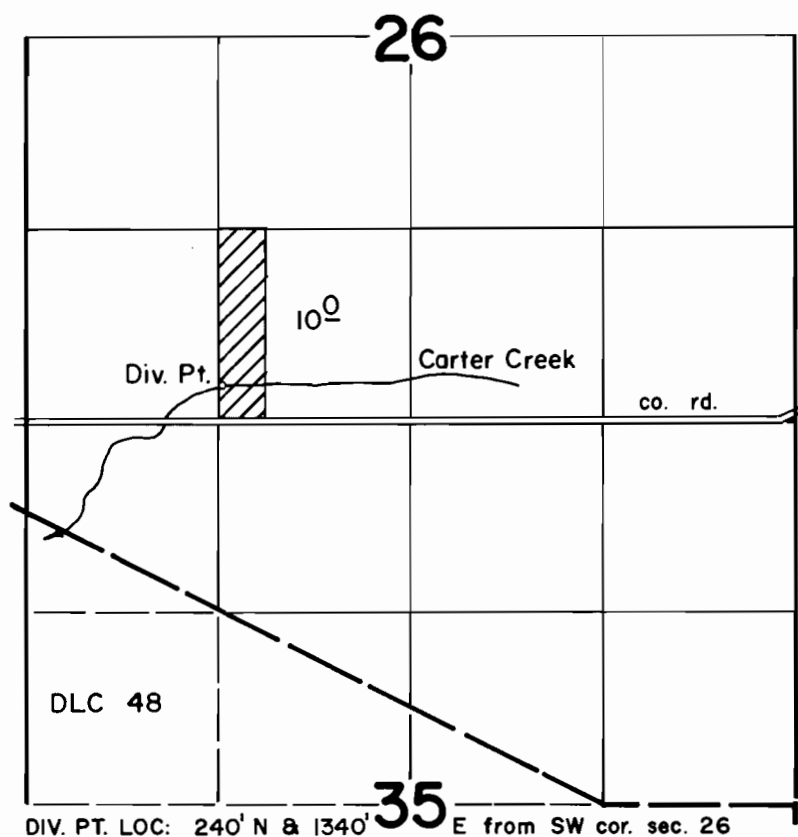

FINAL PROOF SURVEY
UNDER

Application No. 51938 Permit No. 39073
IN NAME OF

NORMAN & IRENE WILLEY

Surveyed Mar. 29 1976, by D. Norby