


T.9S., R.1W., W.M.

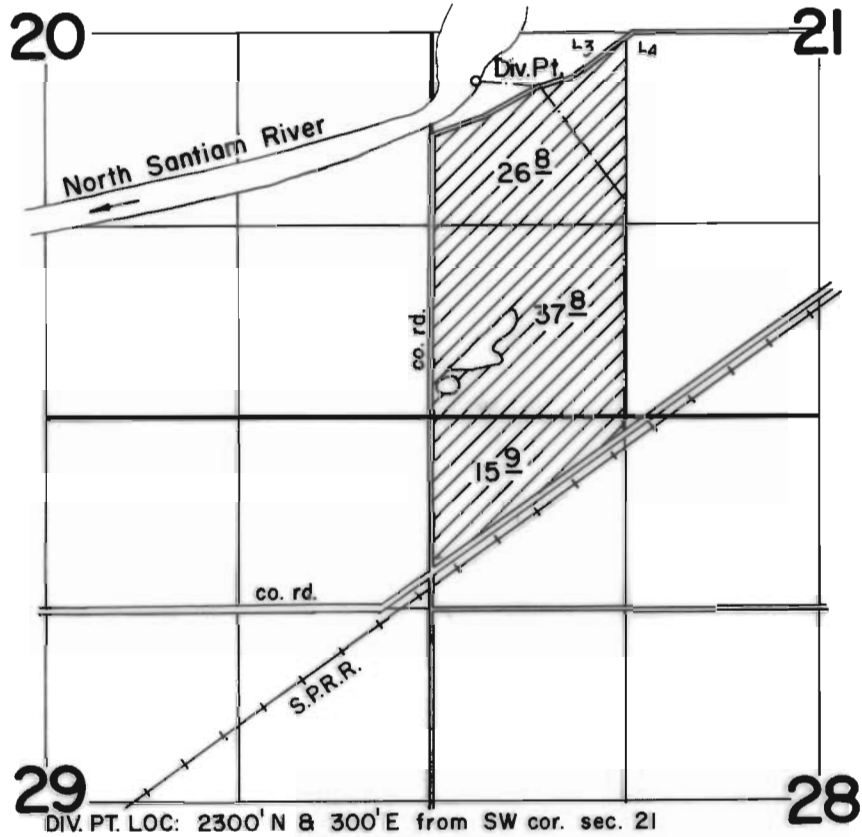

FINAL PROOF SURVEY
UNDER

Application No. 52715 Permit No. 39700
IN NAME OF

ANDREW J. SILBERNAGEL

Surveyed Sept. 10 1976, by D. Norby