


T.10S., R.1W., W.M.

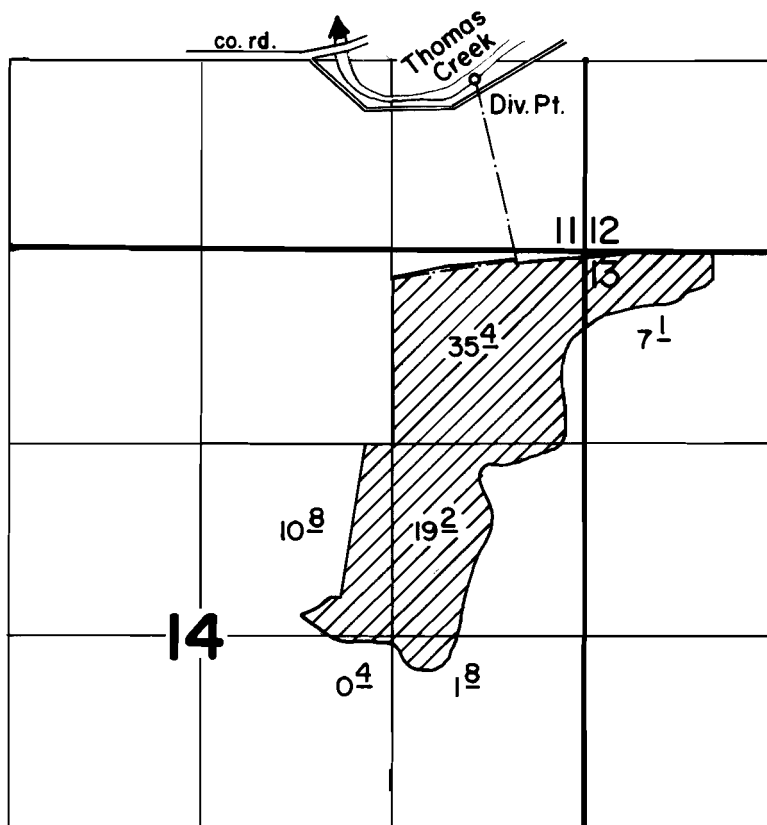

DIV. PT. LOC: 1170' N & 760' W from SE cor. sec. 11

FINAL PROOF SURVEY UNDER

Application No. 53229 Permit No. 39501
IN NAME OF

GENE HALSEY

Surveyed Mar. 31, 1976, by D. Norby