


T.14S., R.1W., W.M.

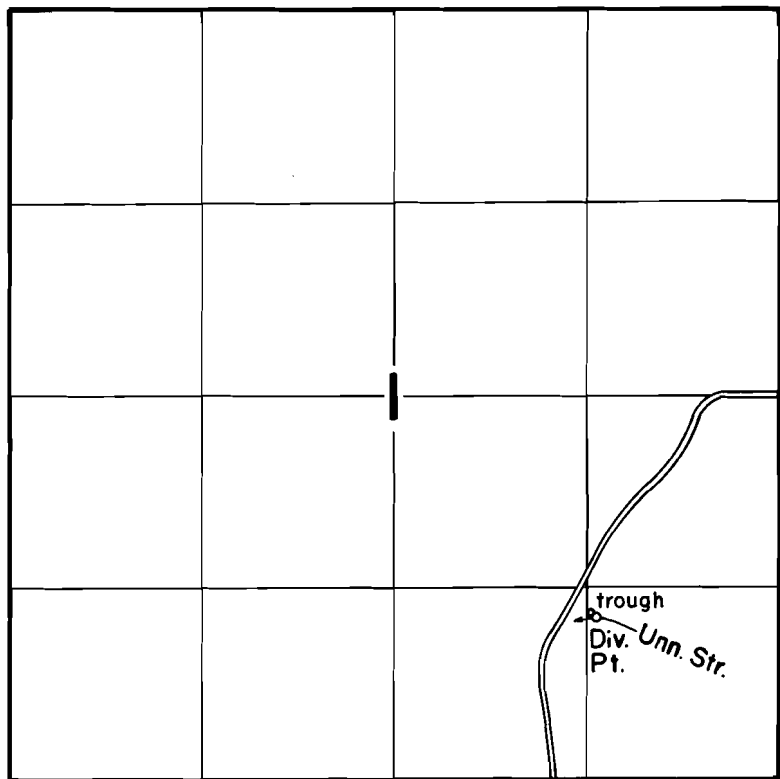

DIV. PT. LOC: 1120' N & 1250' W from SE cor. sec. 1

FINAL PROOF SURVEY
UNDER

Application No. 53336 Permit No. 38632
IN NAME OF

A. J. SPORTSMAN

Surveyed May 4 1976, by D. Norby