


T.6S.,R.2W.,W.M.

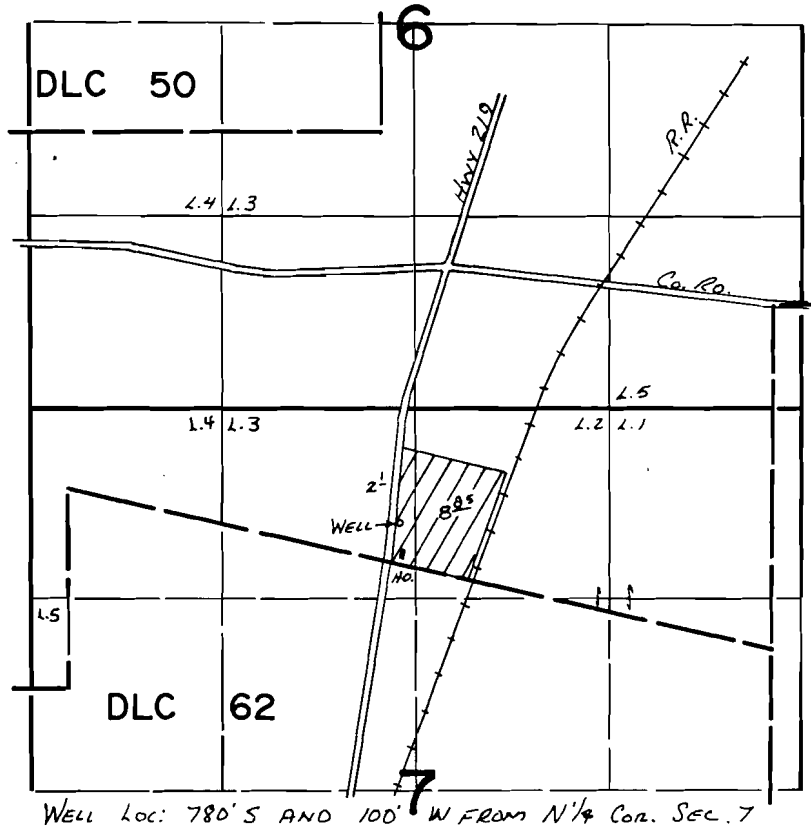

FINAL PROOF SURVEY
UNDER

Application No. G-5332. Permit No. G-5282.
IN NAME OF

.....RALPH F. ORTON.....

Surveyed MAY 19, 1976, by L. TOLL.....