


T.6S.,R.2W.,W.M.

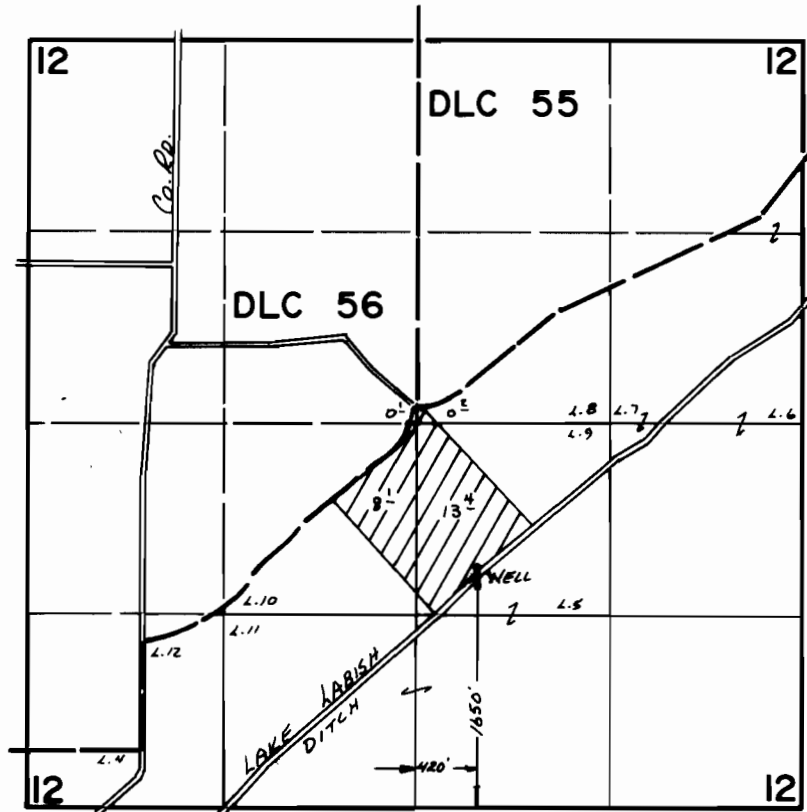

FINAL PROOF SURVEY
UNDER

Application No. G-5799 Permit No. G-5564
IN NAME OF

CLARENCE SCHMIDT

Surveyed JUNE 2, 1976, by L. TOLL