


# T.9S.,R.2W.,W.M.

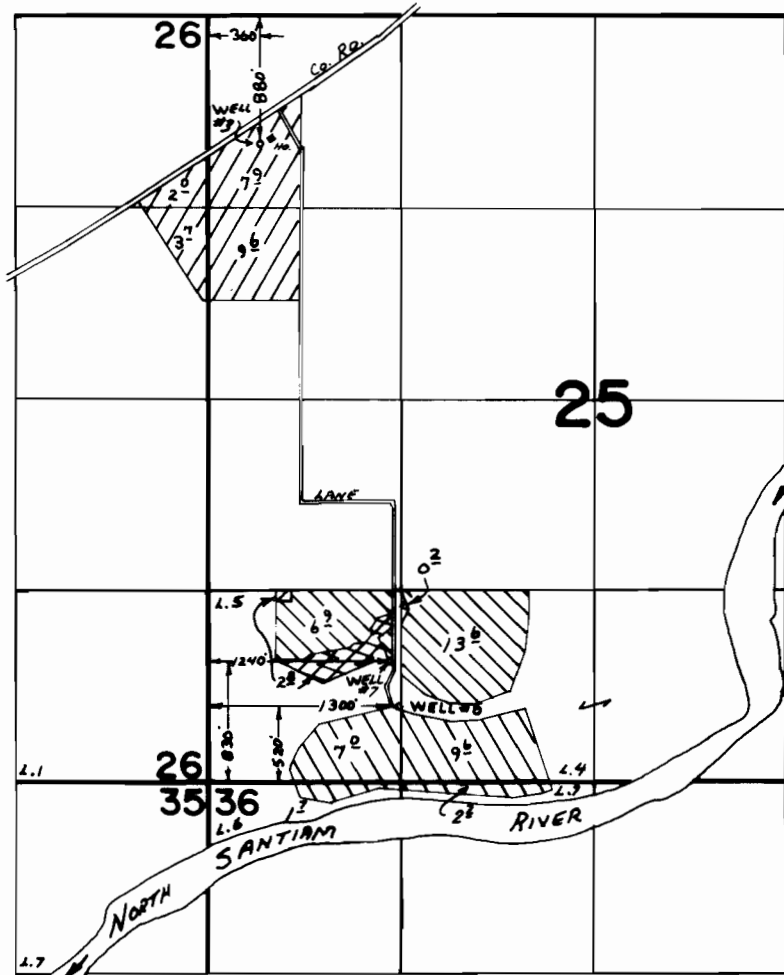

## FINAL PROOF SURVEY UNDER

G-6117                      G-5791 -  
 G-6118                      G-5792 -  
 Application No. G-6119    Permit No. G-5793 -  
 IN NAME OF



NO PERMIT  
FOR THIS LAND -



..... LOUIS SCOFIELD .....

Surveyed SEPT. 7, 1976, by L. TOLL .....