


T.9S.,R.2W.,W.M.

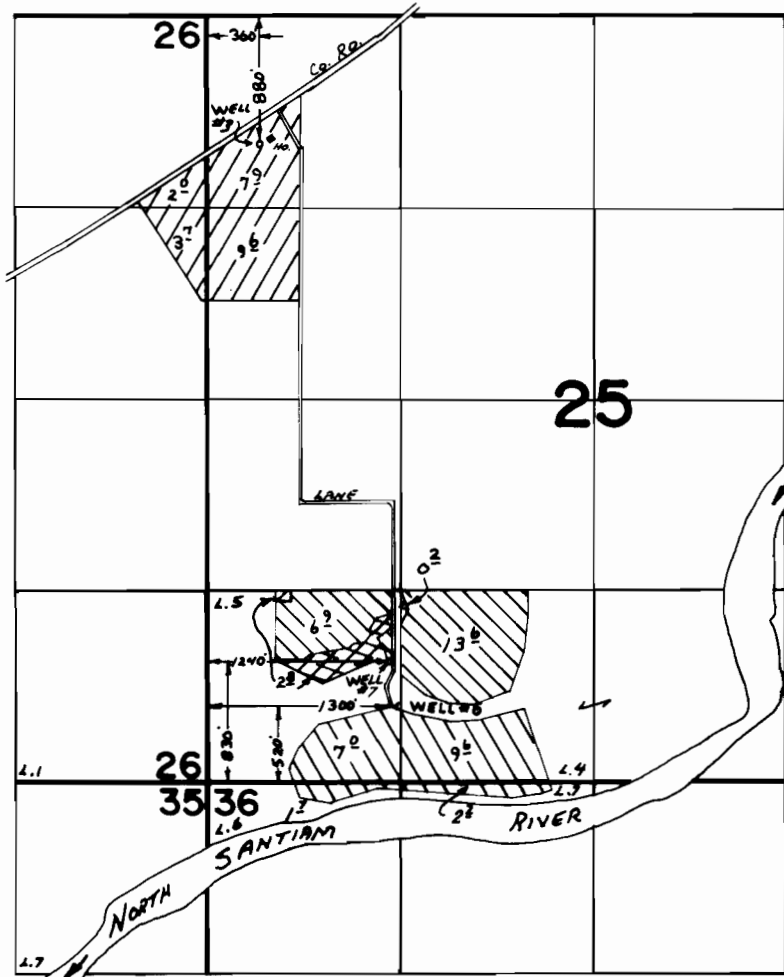

FINAL PROOF SURVEY UNDER

G-6117	G-5791 -	
G-6118	G-5792 -	
Application No. G-6119	Permit No. G-5793 -	

No PERMIT FOR THIS LAND

IN NAME OF

LOUIS SCOFIELD

Surveyed SEPT. 7, 1976, by L. Toll